


T. 6S. R. 1E. W.M.

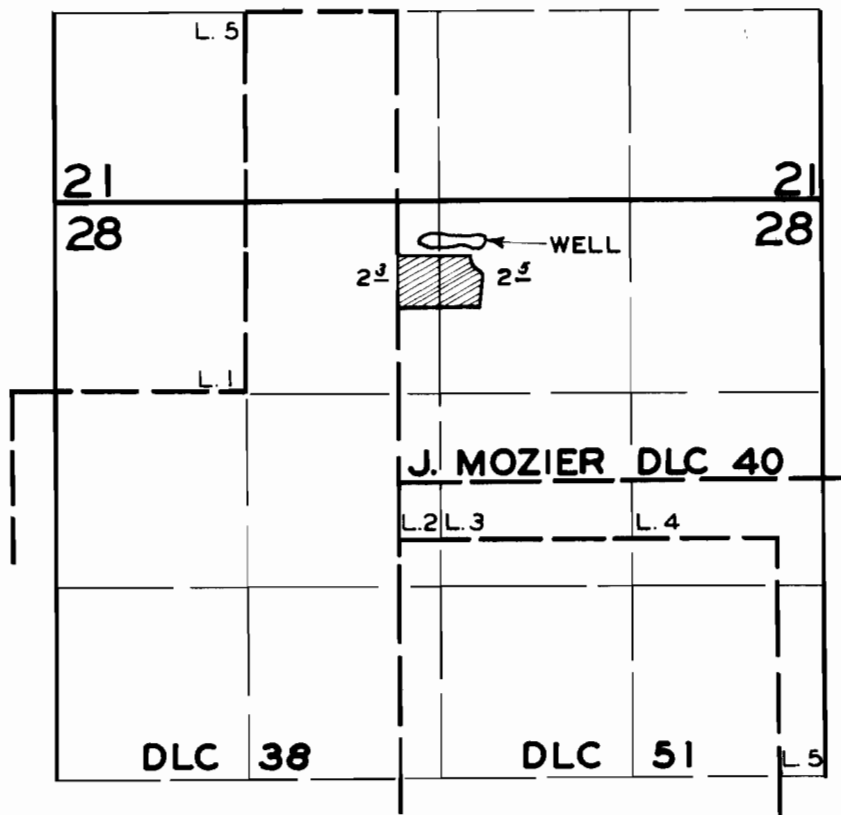

FINAL PROOF SURVEY
UNDER

Application No. G.781 Permit No. G.723
IN NAME OF

VINNIE R. HEINZ

Surveyed NOV. 4, 1960, by R. H. JACKSON