


T. 8S. R. 4W. W.M.

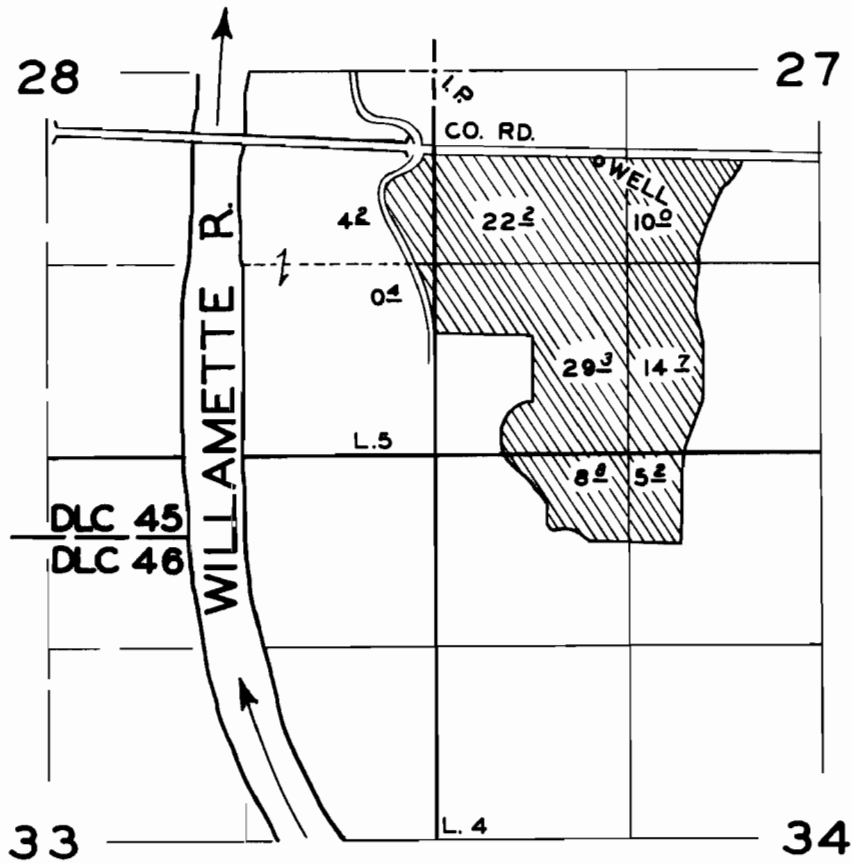

**FINAL PROOF SURVEY**  
UNDER

Application No. G. 985..... Permit No. G. 841.....  
IN NAME OF

**4-D FARMS**

Surveyed MAY 19 1960, by *[Signature]*