



Section 10  
Range 26

Township 3 N  
E.W.M.

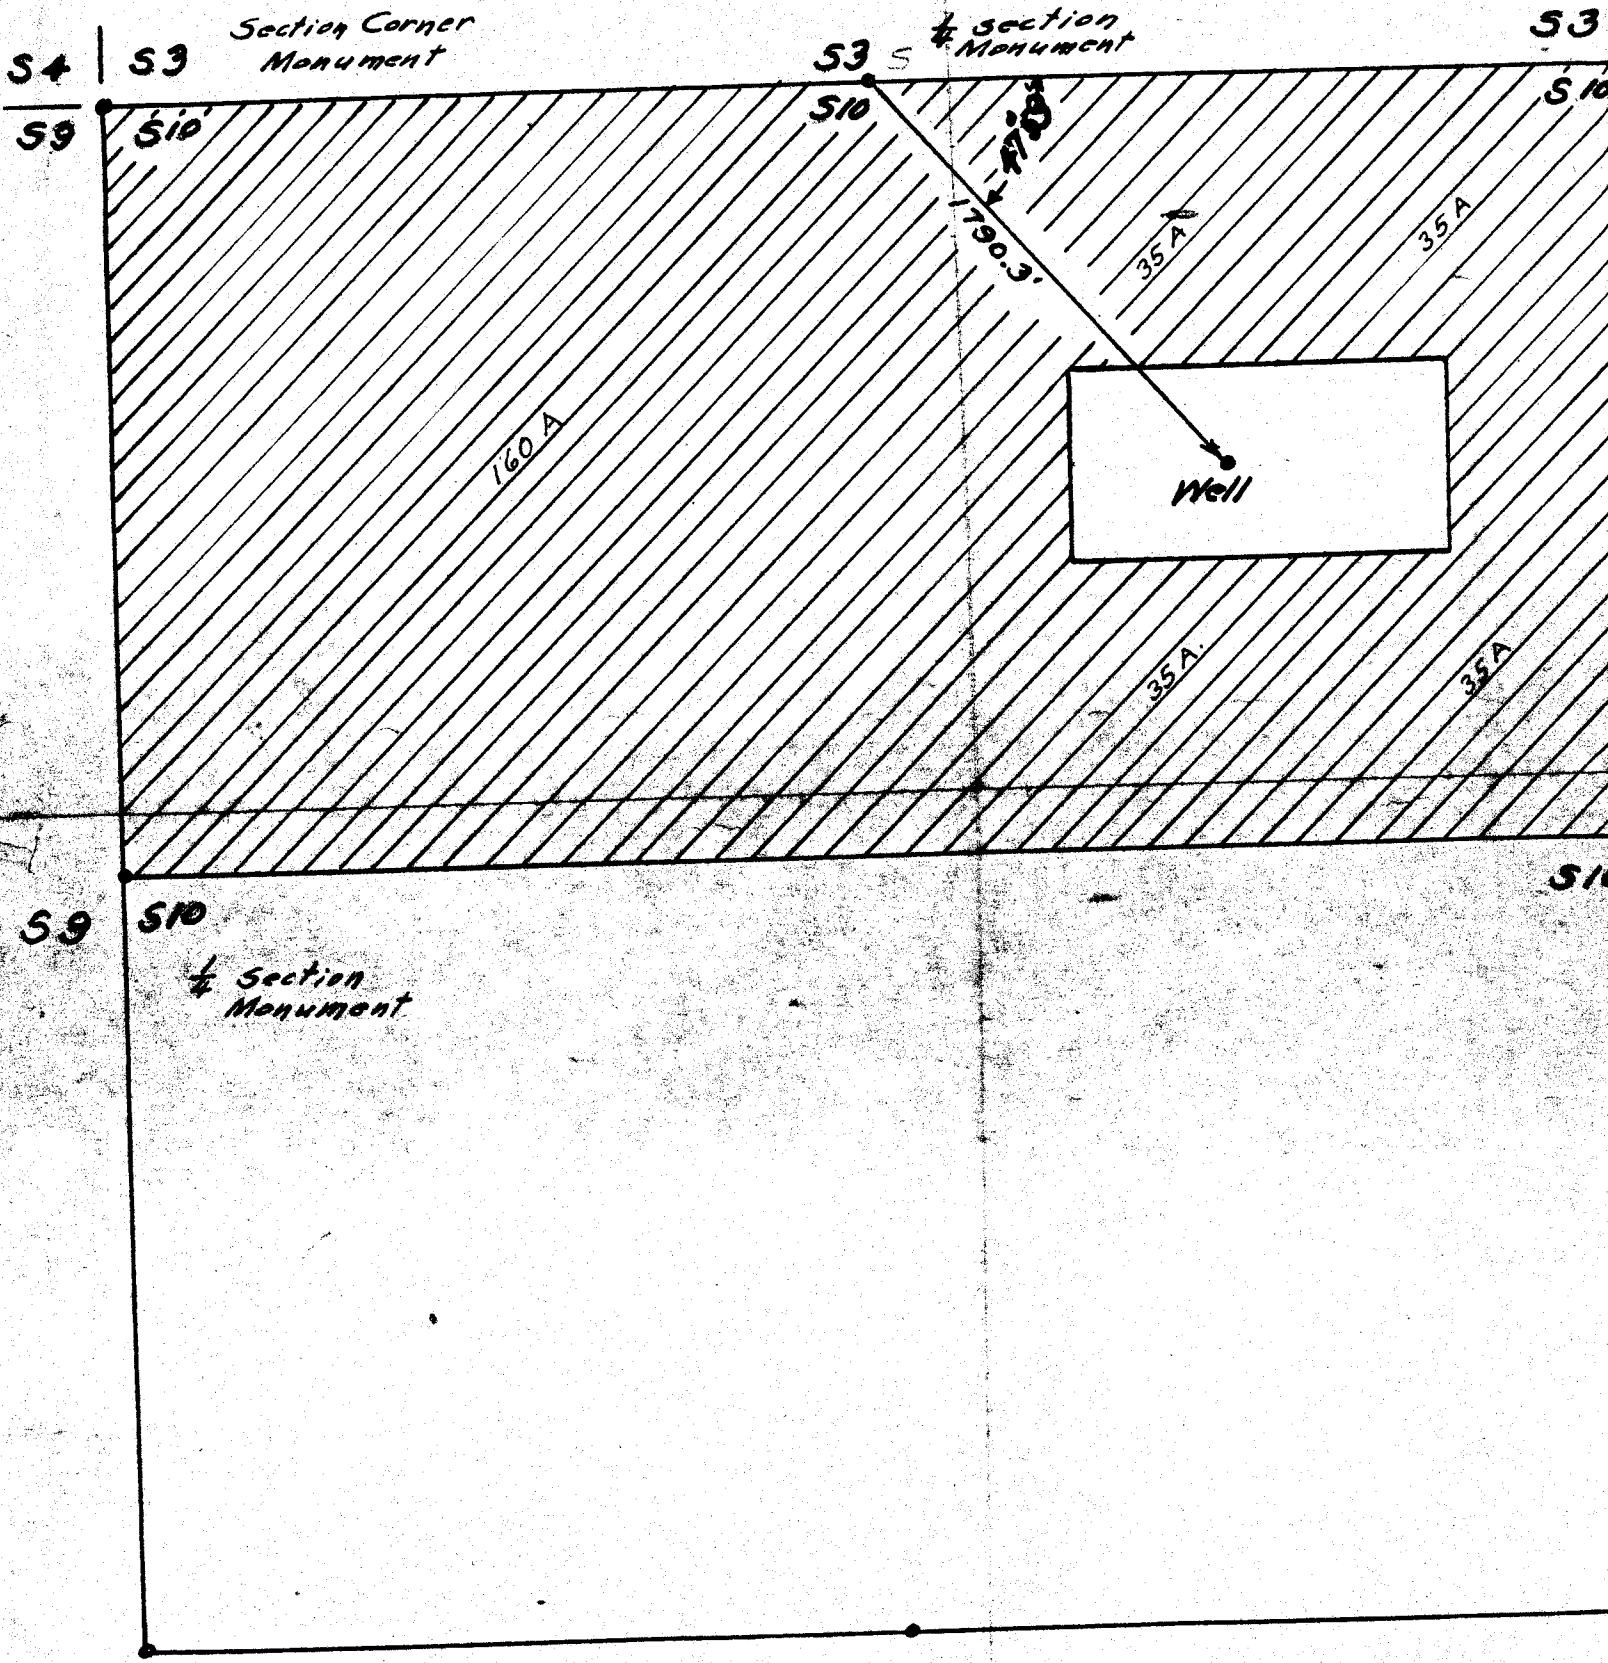


Section Corner Monument

3  
59  
10  
511

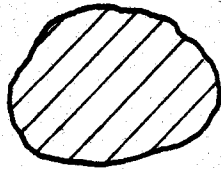

Area Proposed to be Irrigated With New Permit

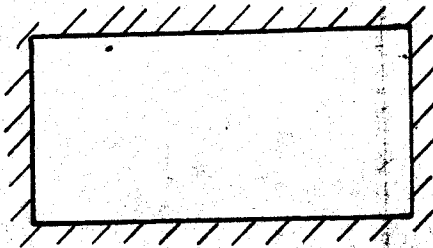

Well Drilled and Irrigation of this Area Covered by Application No U-600, Permit No U551

1/4 Section Monument  
10  
511

Portable Sprinkle System To Be Used

Monuments are U.S. General Land Office Survey 1939

I Chauncey R Hacker of Ordnance, Oregon do hereby certify that this map was made from notes taken during an actual Survey made by me on 23 of August 1958 that the Monuments shown on this map Consisting of existing 12" Caseo Well is 1790.3 ft, South 47° 59' East of Quarry Corner Bet. 3.9 and S10, T4N R26, E.W.M.

Application No. G-4224  
Permit No. G-1119

