


T. 6S. R. 2W. W.M.

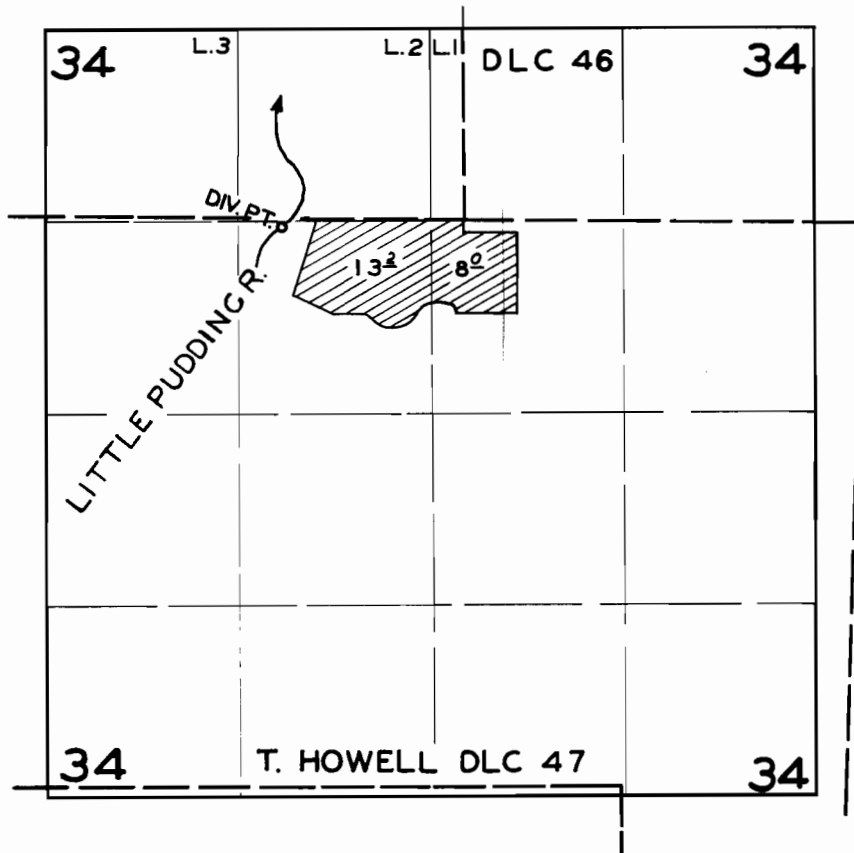

FINAL PROOF SURVEY
UNDER

Application No. 31227 Permit No. 24613
IN NAME OF

LAURENCE G. DEHUTT

Surveyed JUNE 3 1960, by C. O. BARTELS