


T. 7S. R. 3W. W.M.

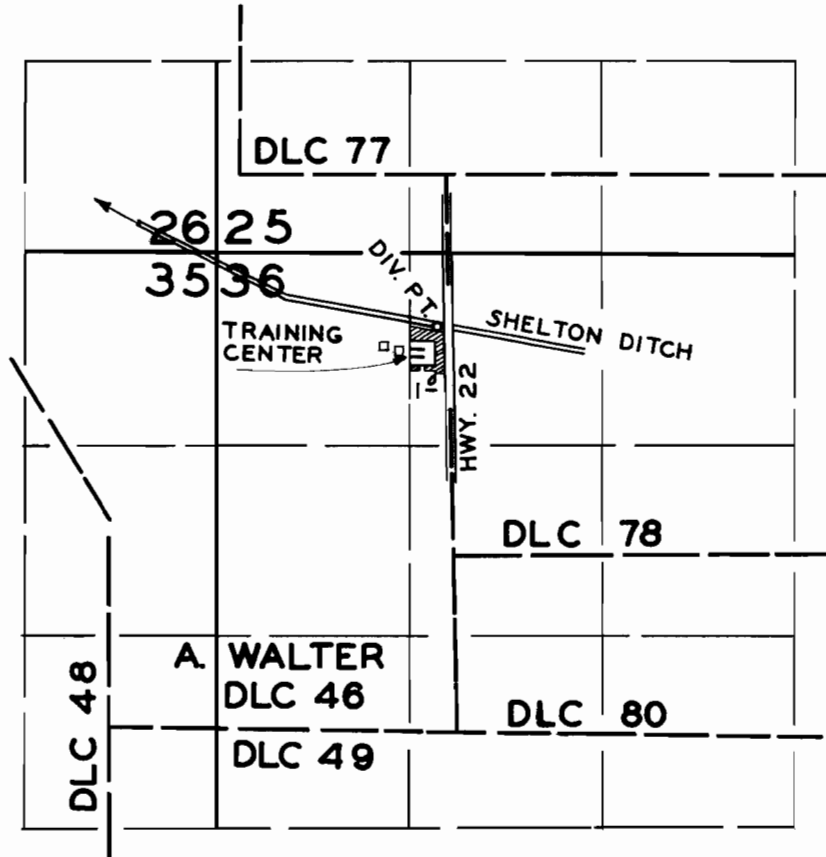

FINAL PROOF SURVEY
UNDER

Application No. 32748 Permit No. 25848
IN NAME OF
U. S. NAVY & MARINE CORPS
RESERVE TRAINING CENTER

Surveyed MAY 16 1960, by [Signature]