


T.9S.R.6W.W.M.

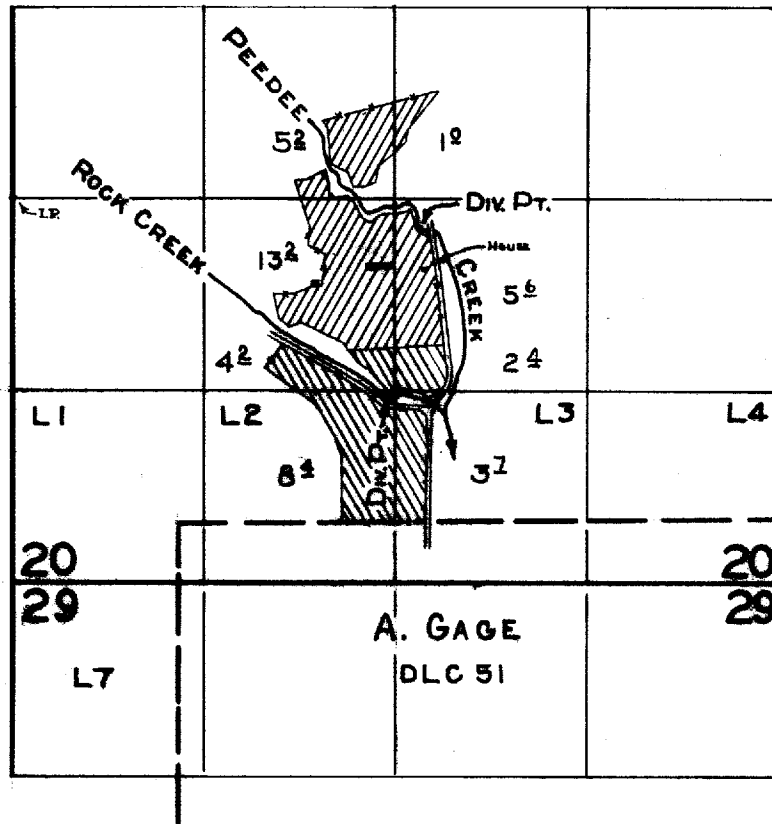

**FINAL PROOF SURVEY**  
UNDER

Application No. 28492... Permit No. 22312...  
IN NAME OF

..... CECIL H. & VERA JACKETS .....

Surveyed SEPT. 6. 1960, by M. BISH .....

1960-E

MC