


T. 1N. R. 32E. W.M.

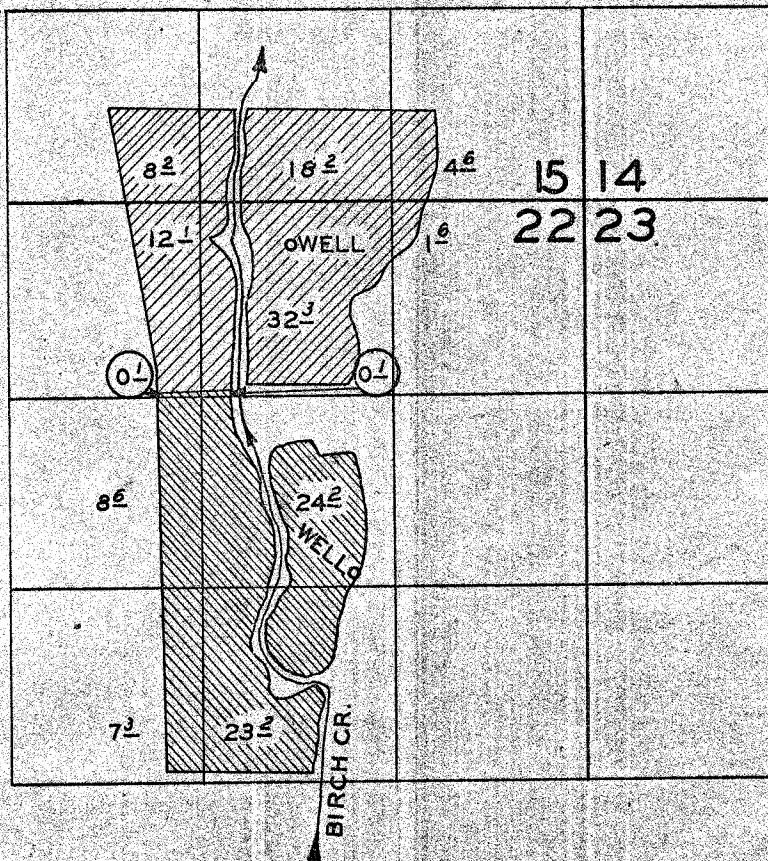

FINAL PROOF SURVEY UNDER

Application No. U606 Permit No. U555
IN NAME OF

J.L. & GOLDIE BERTHA ELDRIDGE

Surveyed JULY 12, 1960, by