


~~U-588~~
u-586
C-28598

T.6N.R.34E.W.M.

SEE REPORT APPL
G-3372
N.W. COR. S 1/2 SW 1/4 SEC. 18
IS 2442.87' S. OF SEC. LINE

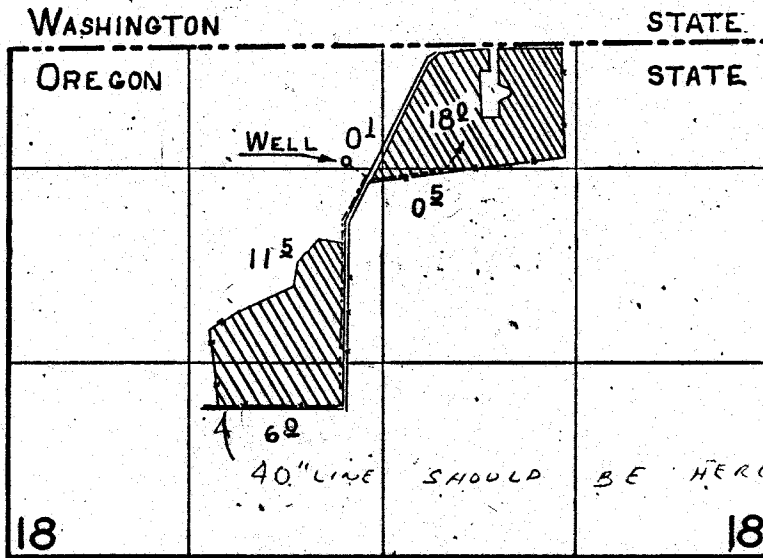

FINAL PROOF SURVEY UNDER

Application No. U-570 Permit No. U-588
IN NAME OF

ESTATE OF E. C. BURLINGAME SR.

Surveyed JULY 20, 1960, by M. BISH