


G-137  
28599.

# T. 1N. R. 32E. W.M.

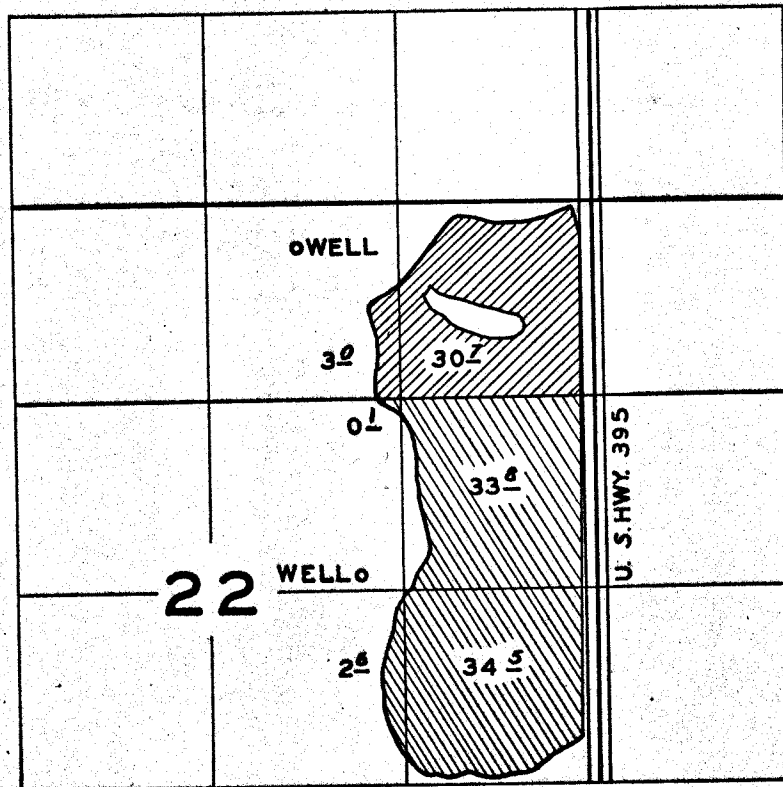

## FINAL PROOF SURVEY UNDER

Application No. G.219..... Permit No. G.137.....  
IN NAME OF

**J.L. & GOLDIE BERTHA ELDRIDGE**

Surveyed JULY 12, 1960, by

*[Handwritten Signature]*