


G-394

28600

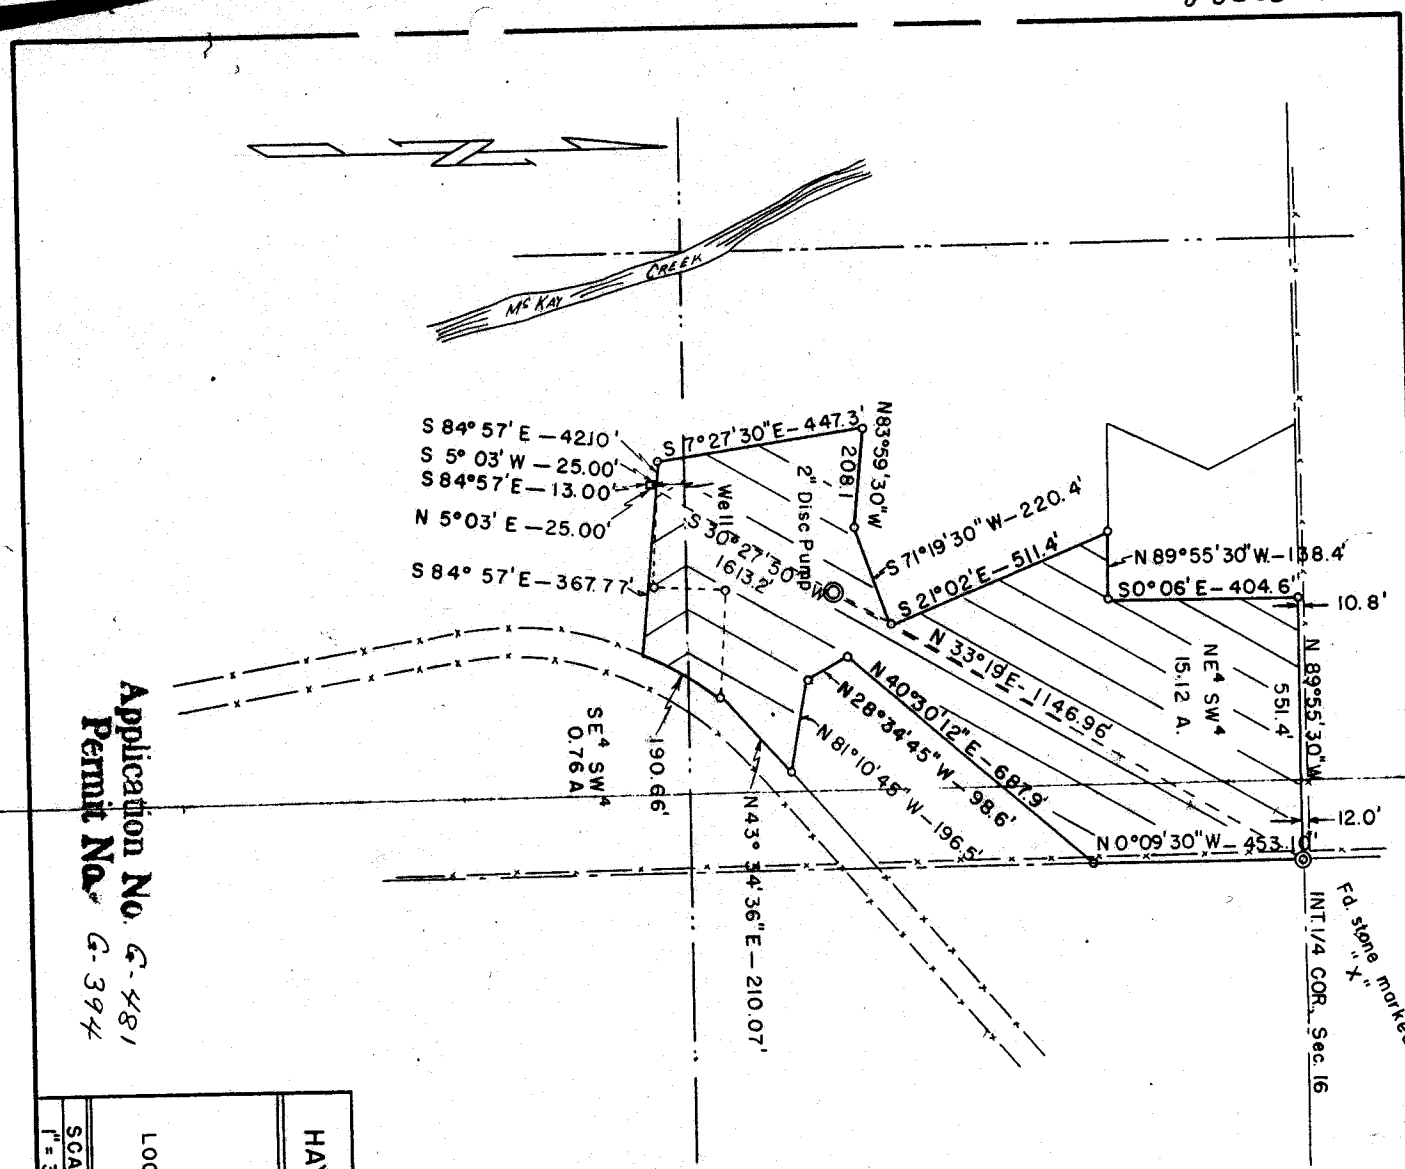

Application No. G-481
 Permit No. G-394

HAYES & HARRIS ENGINEERING				
SURVEY FOR JOHN FIX				
LOCATION OF WELL & AREA TO BE IRRIGATED				
S. 16, T. 2 N., R. 32 E., W.M.				
SCALE	DATE	DRN.	BY	DRN. NO.
1" = 300'	8/8/56		W.O.H.	

REGISTERED
 OREGON
 LAND SURVEYOR
Wayne O. Harris
 MAY 6, 1958
 WAYNE O. HARRIS
 346