


T. 2N. R. 32E. W.M.

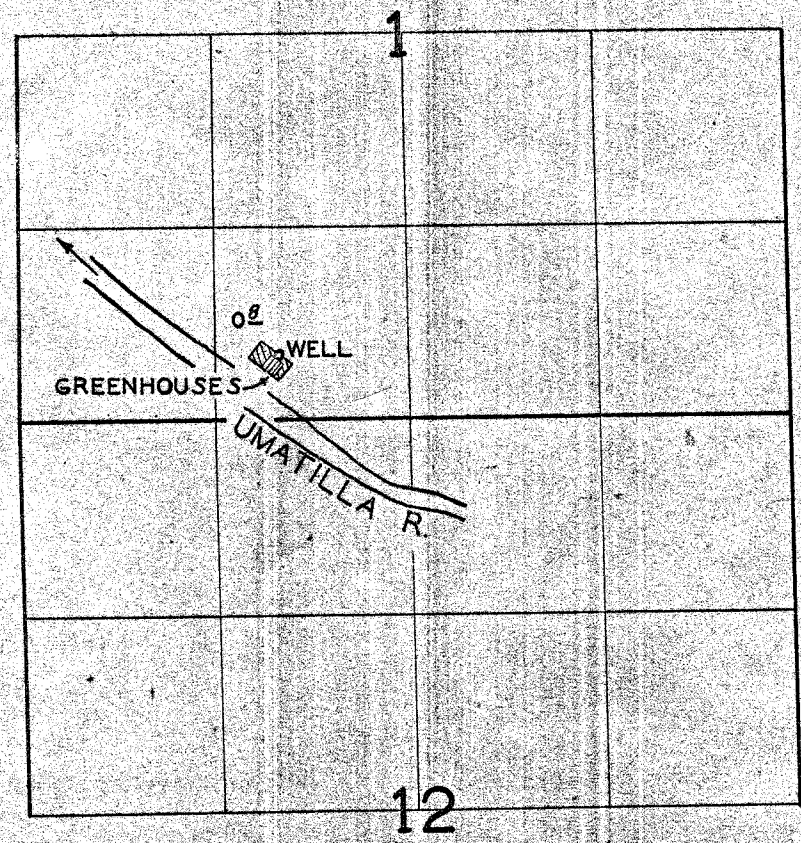

FINAL PROOF SURVEY
UNDER

Application No. G 917 Permit No. G1018
IN NAME OF

CHARLES L. & LELIA I. WHITE

Surveyed JULY 14 1960, by R. Jackson