


G-1114

28605

T.6N.R.35&36E.W.M.

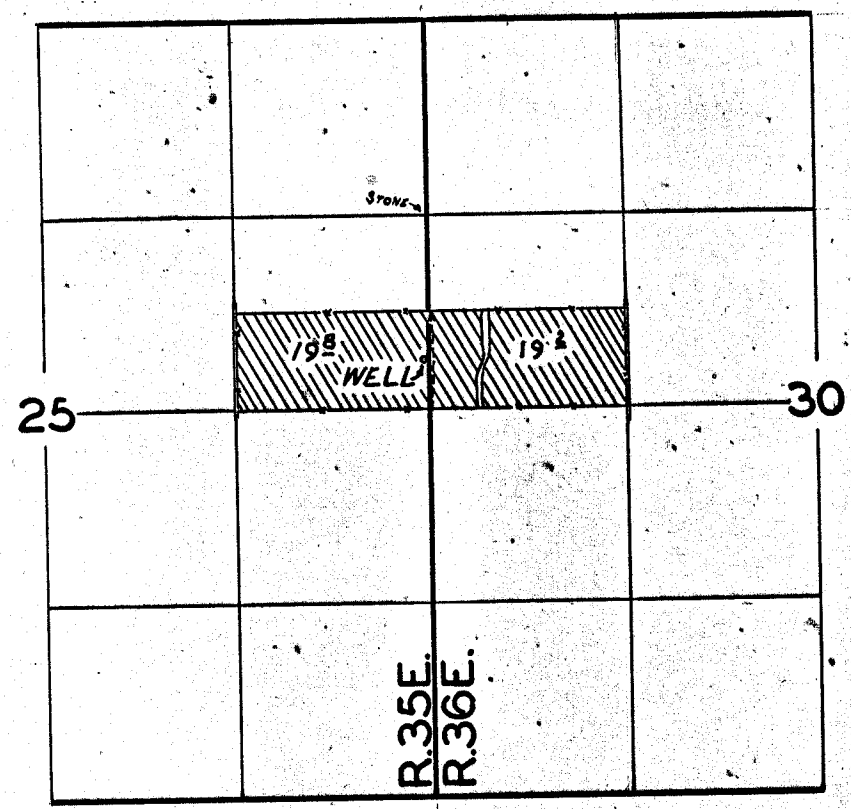

FINAL PROOF SURVEY UNDER

Application No. G.1214 Permit No. G.1114
IN NAME OF

HAROLD STILLER

Surveyed JULY 12, 1960, by M. BISH

NZ-6P-64