


6-1142

28606

# T. 2N. R. 30E. W. M.

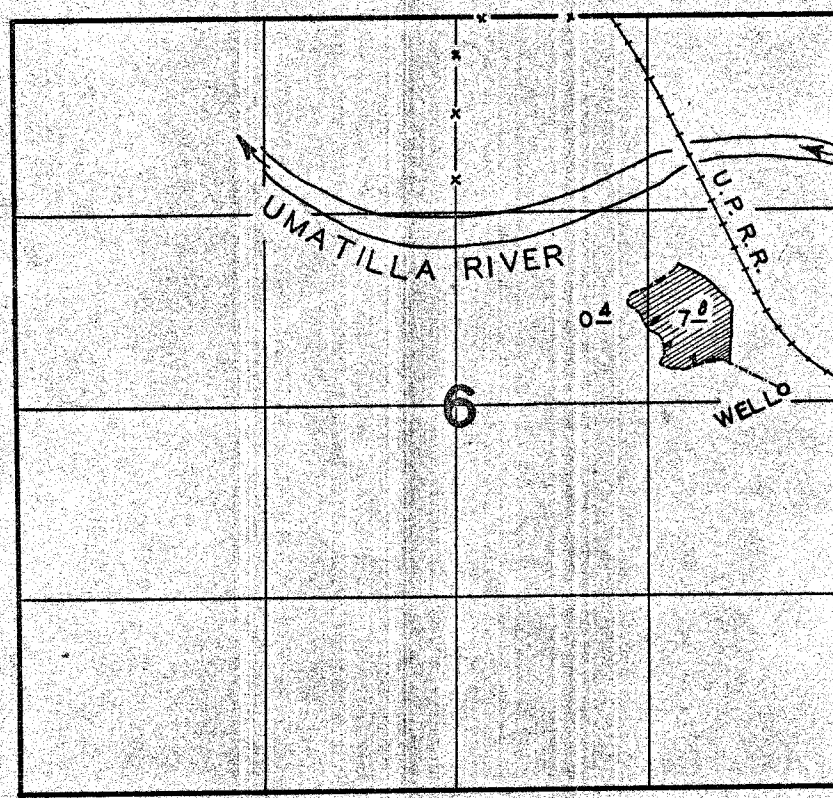

## FINAL PROOF SURVEY UNDER

Application No. 6 396 Permit No. 61142  
IN NAME OF

CUNNINGHAM SHEEP CO.

Surveyed JULY 22 19 60, by *[Signature]*