


T.6N.R.35E.W.M.

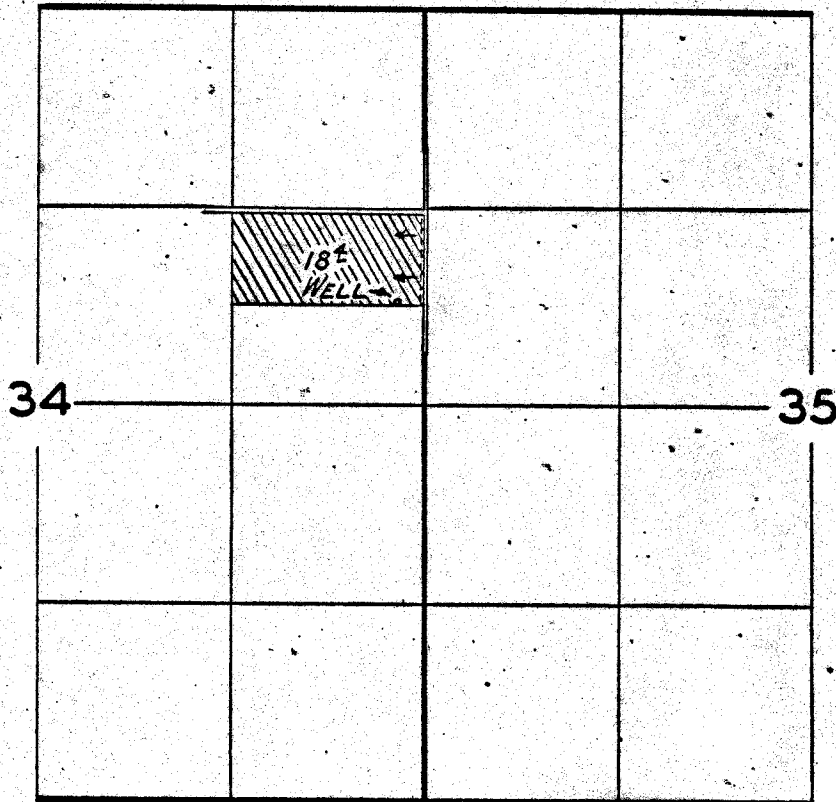

FINAL PROOF SURVEY UNDER

Application No. 41408 Permit No. G1282
IN NAME OF

FRANK HOOKER

Surveyed JULY 12 1960, by M BISH