


T. 2N. R. 32E. W.M.

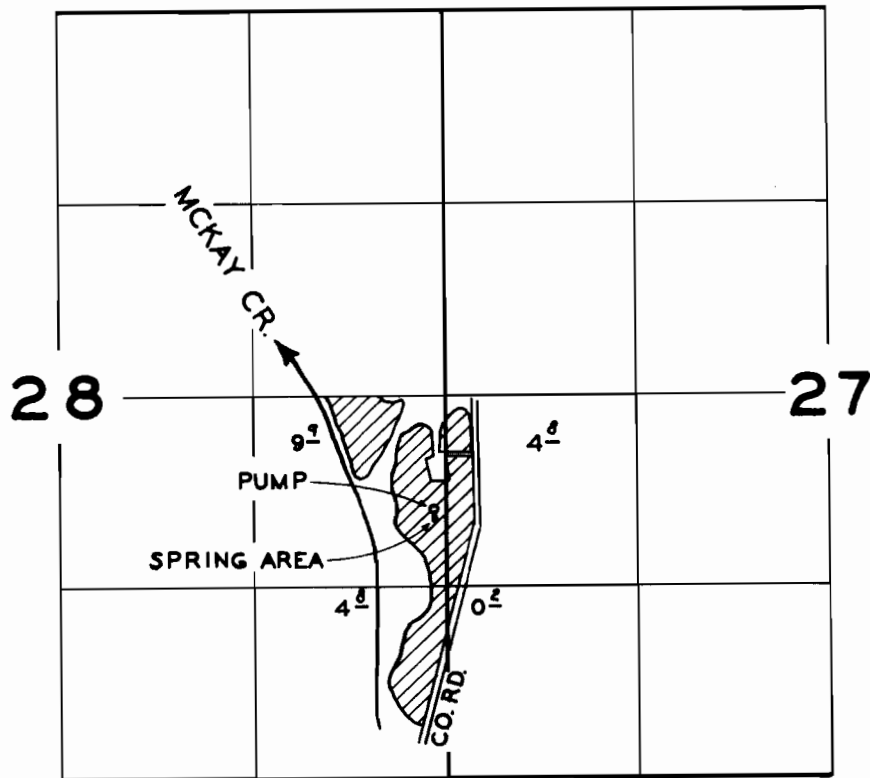

FINAL PROOF SURVEY
UNDER

Application No. 28947 Permit No. 22769
IN NAME OF

ELLIS J. WYLAND

Surveyed JULY 22 1960, by

[Handwritten Signature]