


T. 3N. R. 34E.W.M.

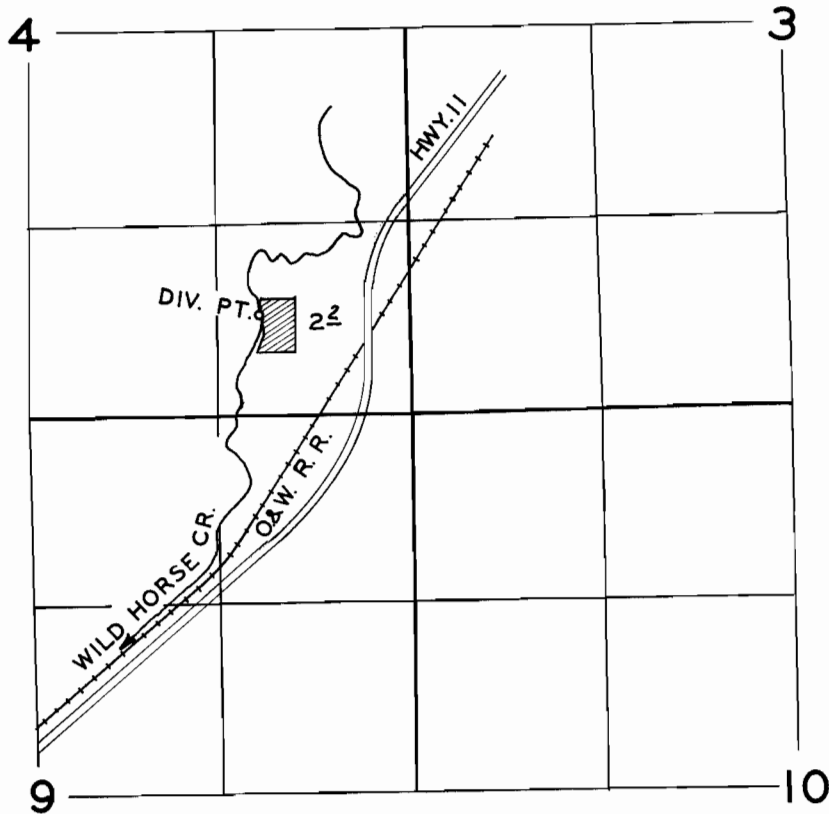

FINAL PROOF SURVEY
UNDER

Application No. 314.9.2... Permit No. 24848...
IN NAME OF

RAY BAUMEISTER

Surveyed JULY 21 19 60, by *[Signature]*