


T. 3S. R. 30E. W.M.

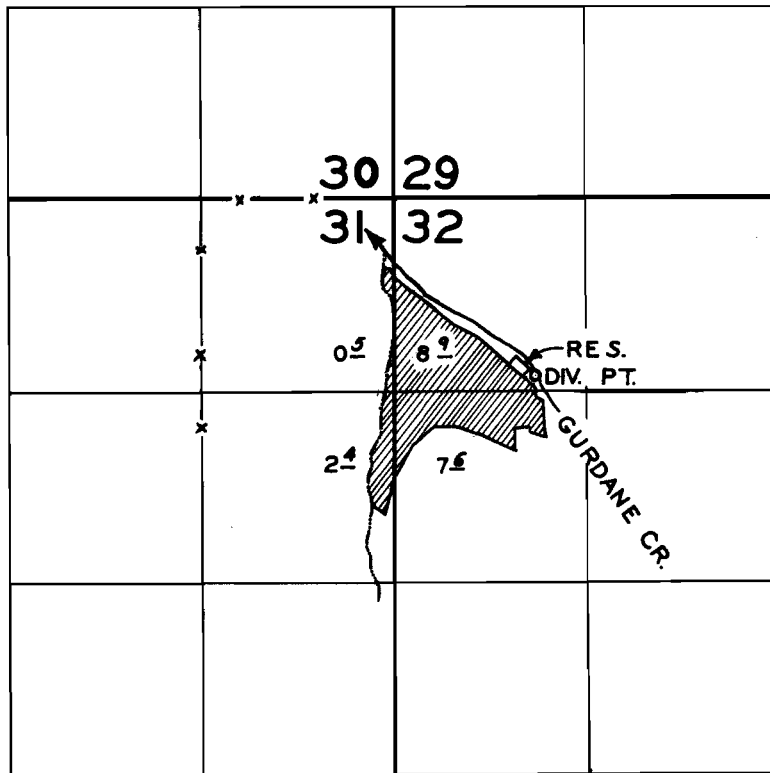

FINAL PROOF SURVEY
UNDER

Application No. R 32189
32190 Permit No. R 2127
25471
IN NAME OF

CON DOHERTY

Surveyed JULY 15, 1960, by

[Signature]