


T. 3S. R. 30E. W.M.

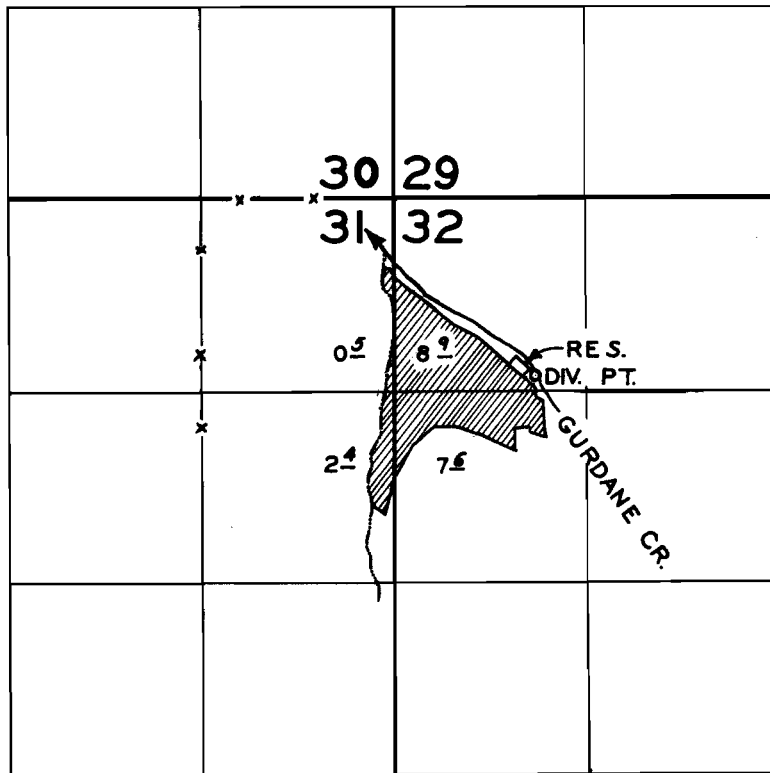

FINAL PROOF SURVEY
UNDER

Application No. R 32189 Permit No. R 2127
32190 IN NAME OF

CON DOHERTY

Surveyed JULY 15, 1960, by

[Handwritten Signature]