


T.2 S. R.2 W.W.M.

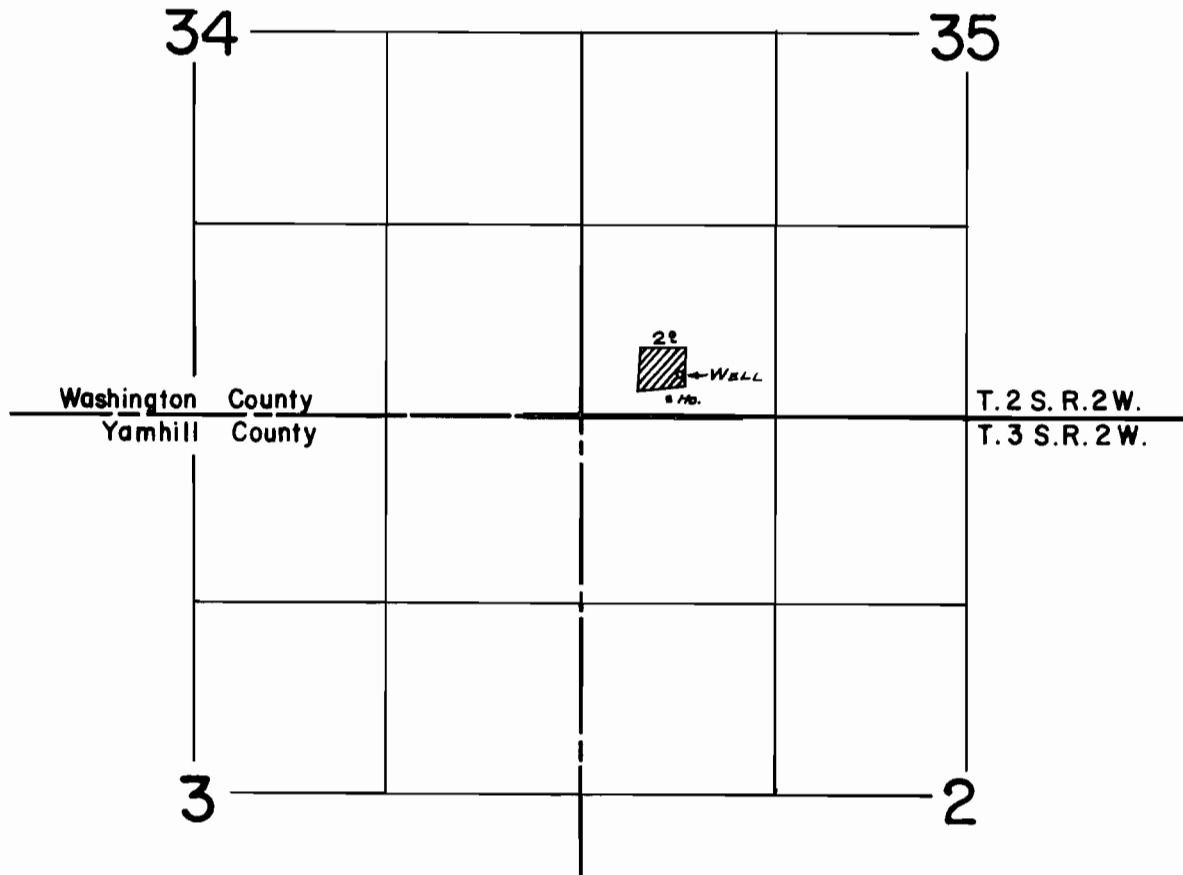

FINAL PROOF SURVEY
UNDER

Application No. G-653 Permit No. G-566
IN NAME OF

RICHARD B. JOYCE

Surveyed June 24 1960, by *J. Jackson*

1960-K