


T.I.S. R. 4 W.W.M.

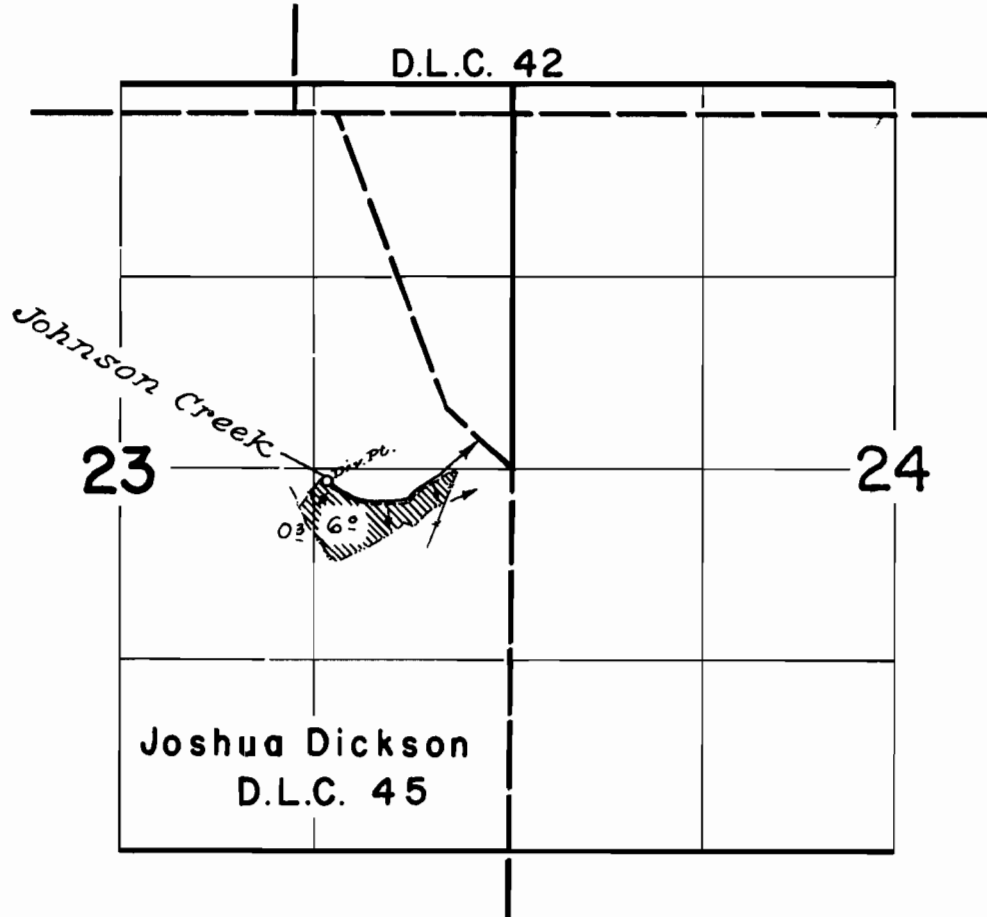

**FINAL PROOF SURVEY**  
UNDER

Application No. 28528 Permit No. 22505  
IN NAME OF

**H. W. & LOUISA SUNDEMEIER**

Surveyed May 25, 1960, by *[Signature]*