


T.2N.R.3W.W.M.

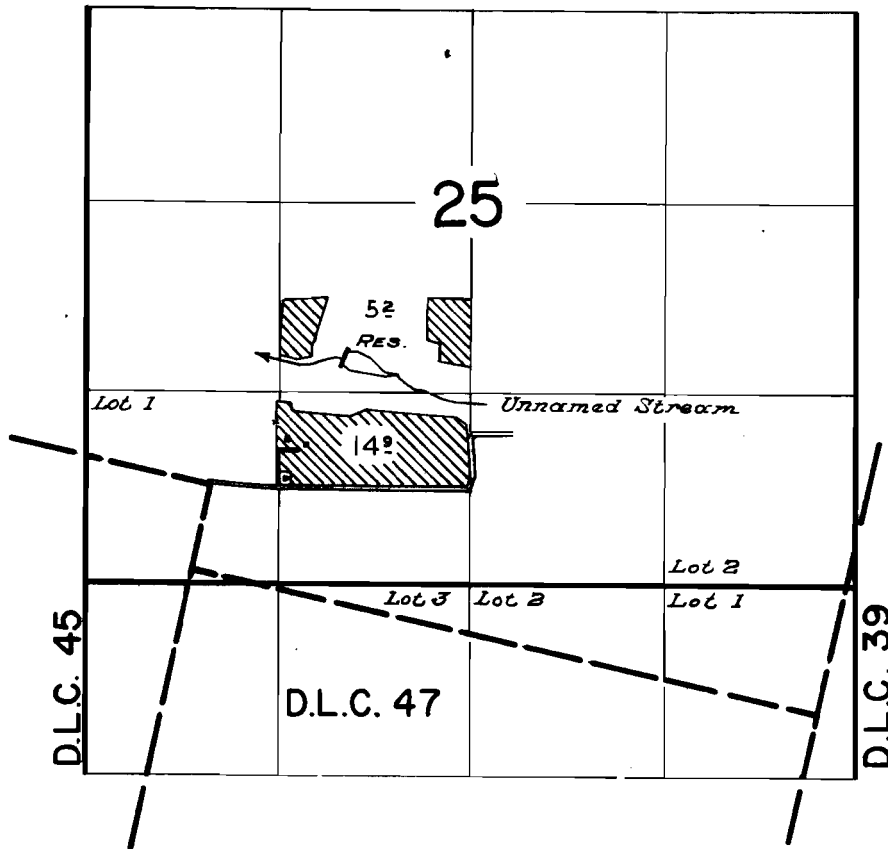

FINAL PROOF SURVEY
UNDER

Application No. ^{R-31222} 31223 Permit No. ^{R-1971} 24609
IN NAME OF

BIGE & BERTHENA TANKERSLEY

Surveyed August 5 1960, by *R. Jackson*