


T. 2 S. R. 1 W. W. M.

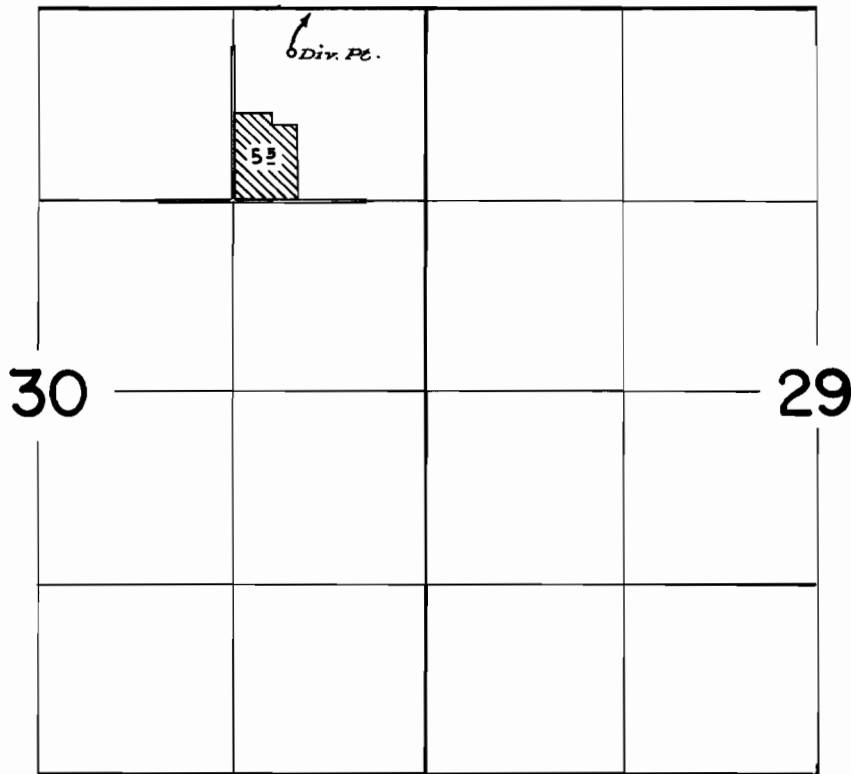

FINAL PROOF SURVEY UNDER

Application No. 31377... Permit No. 24739
IN NAME OF

WALTER & DOROTHY MELZER

Surveyed May 23 1960, by *[Signature]*