


T.1&2S.R.4W.W.M.

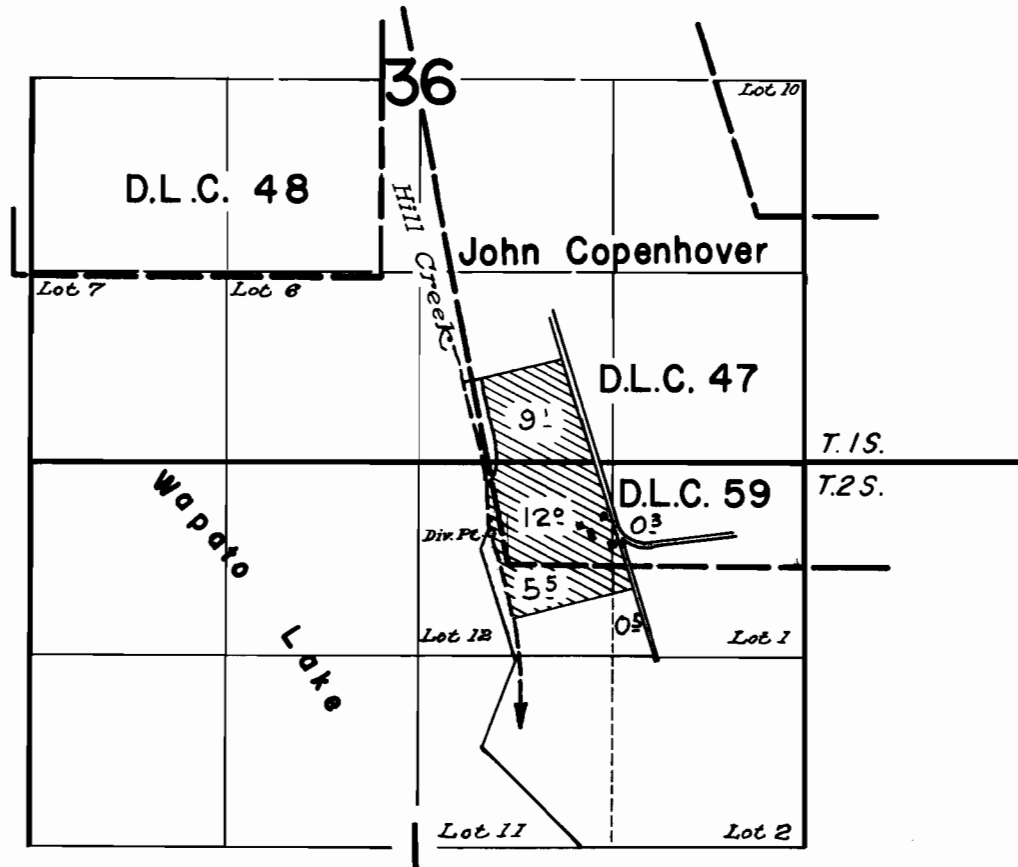

FINAL PROOF SURVEY
UNDER

Application No. 32102 Permit No. 25364
IN NAME OF

JOHN W. SEIDA

Surveyed June 2, 1960, by *[Signature]*