


T. 1 S. R. 4 W. W. M.

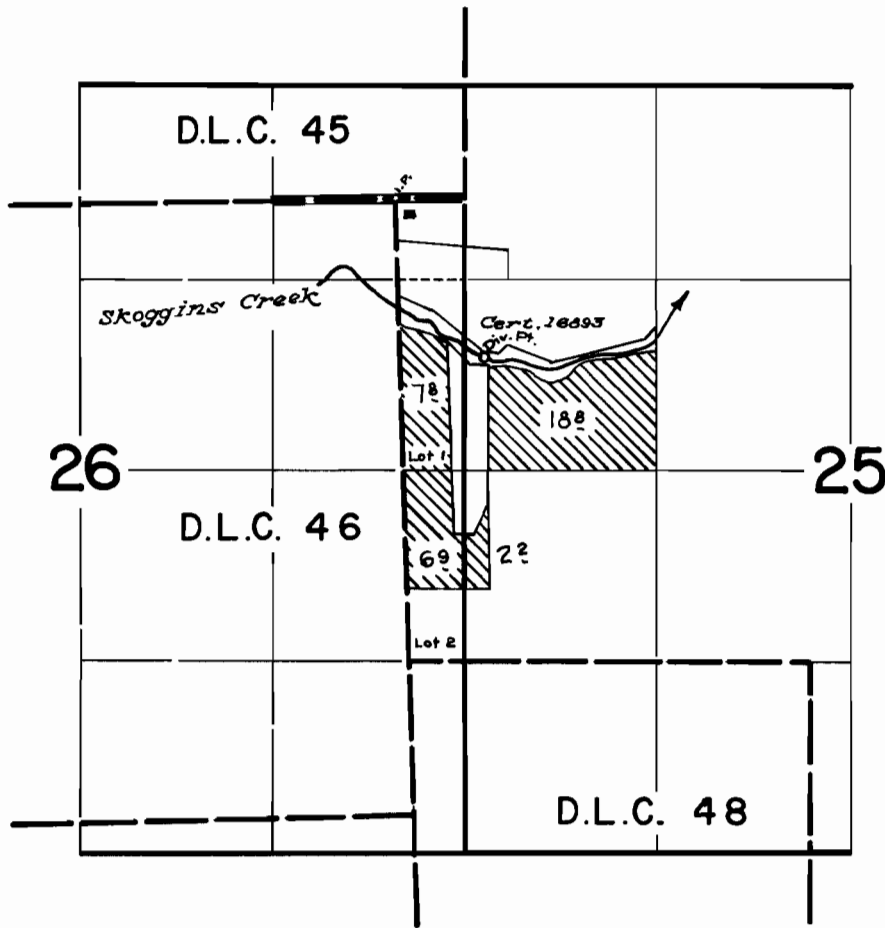

FINAL PROOF SURVEY UNDER

Application No. 29903. Permit No. 23546.
IN NAME OF

GEORGE C. BATALGIA

Surveyed June 2, 1960, by

C. Jackson