


T.1S. R.4 W.W.M.

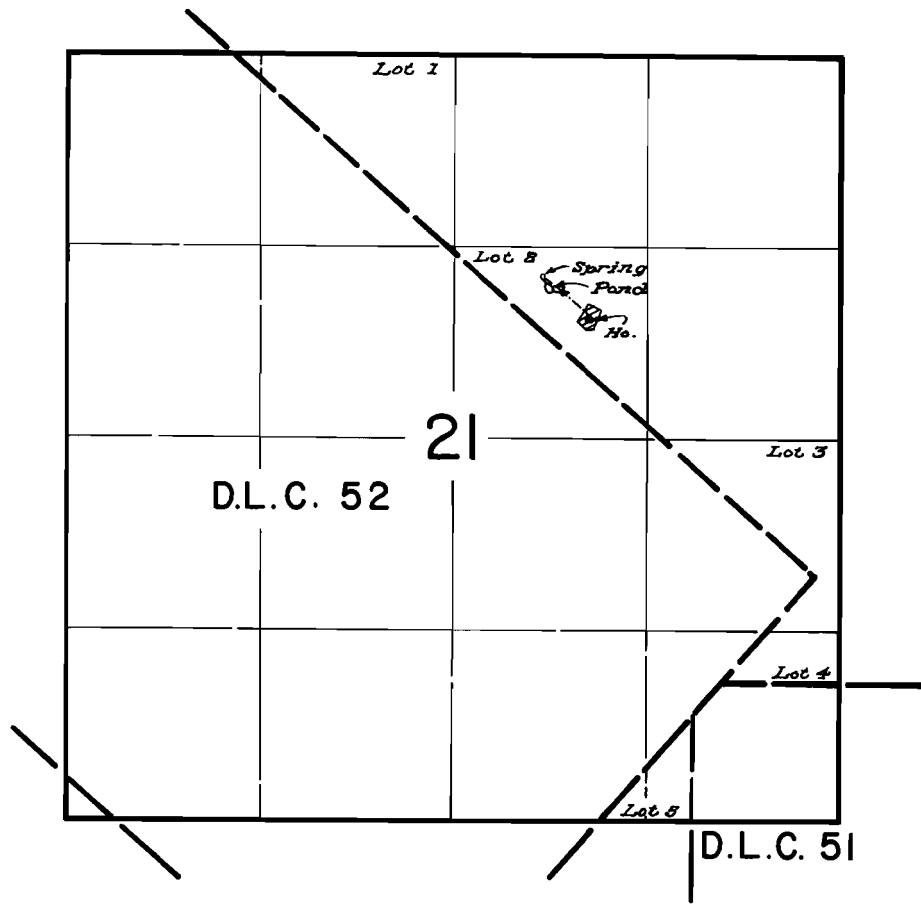

FINAL PROOF SURVEY UNDER

Application No. 30566. Permit No. 24109.
IN NAME OF

CHARLES H. & WILMA M. BALL

Surveyed June 3, 1960, by

A. A. [Signature]