


T. 1N. R. 4W.W.M.

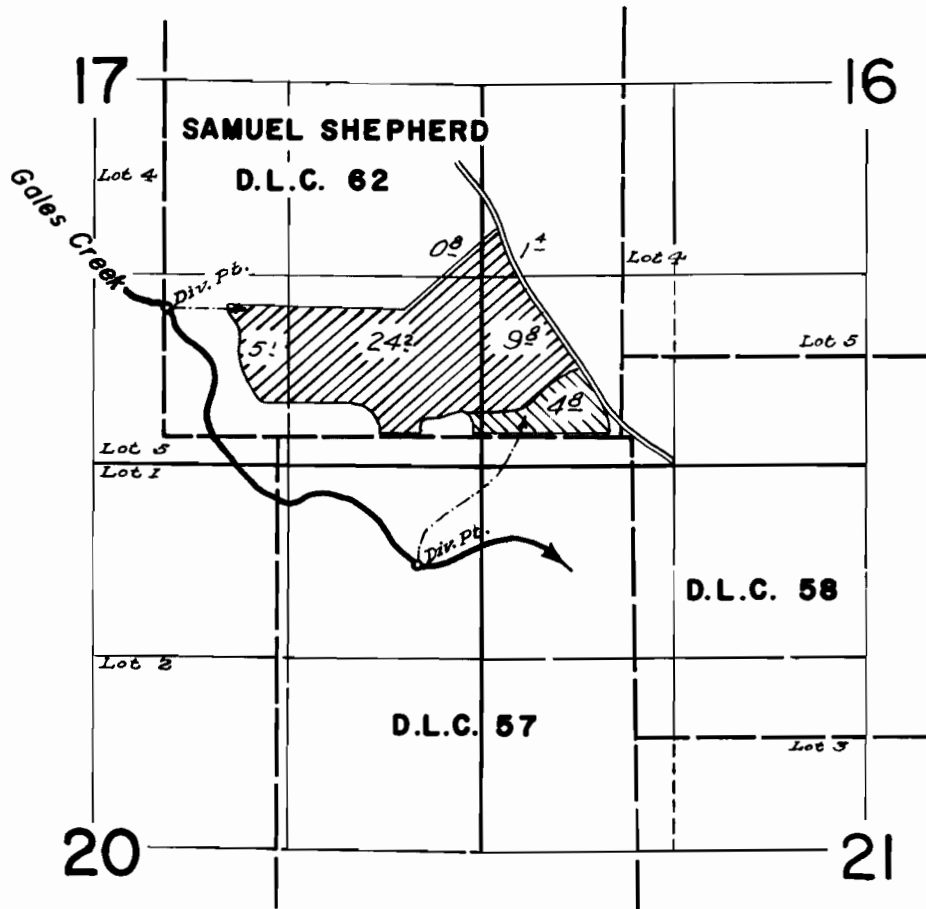

FINAL PROOF SURVEY UNDER

Application No. 31029..... Permit No. 24.4.21.....
IN NAME OF

Emil Carl Dober

Surveyed August 4 1960, by *L. Jackson*