


T.2S. R.2 W.W.M.

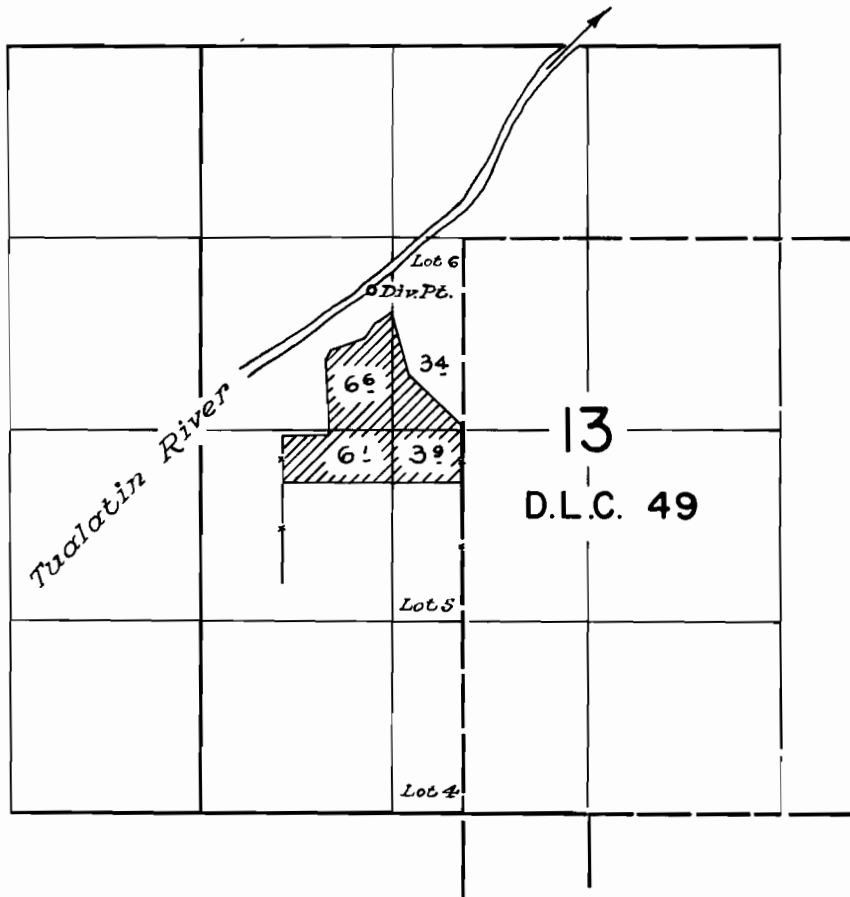

FINAL PROOF SURVEY UNDER

Application No. 31719 Permit No. 25008
IN NAME OF

DONALD F. & ANITA V. WACHLIN

Surveyed June 23, 1960, by

[Handwritten Signature]