


T. 3 S. R. 2 W. W. M.

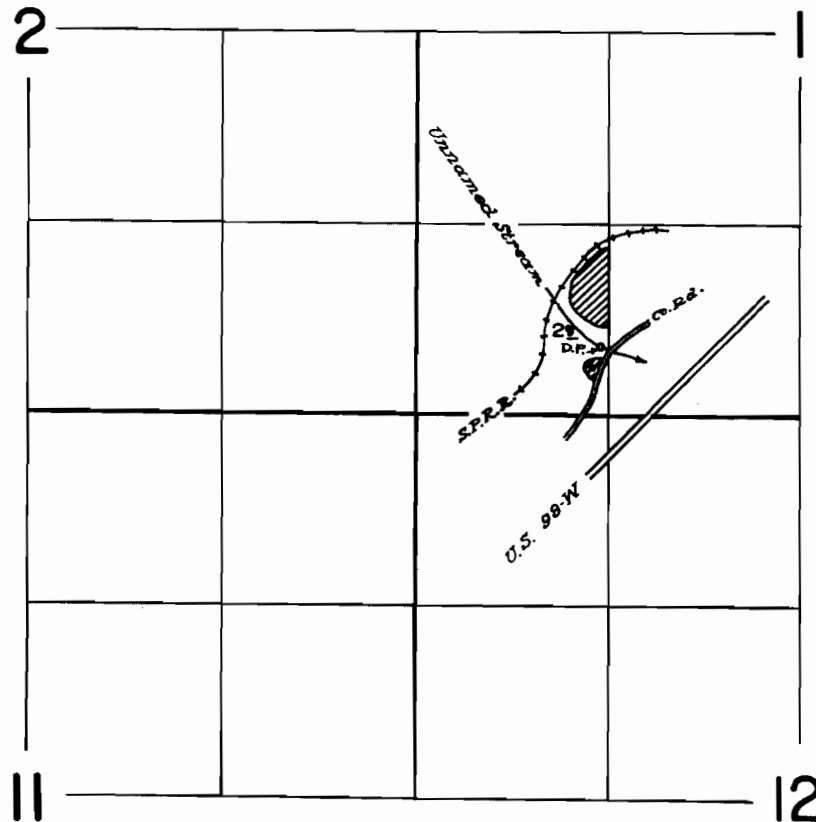

**FINAL PROOF SURVEY**  
UNDER

Application No. 31911..... Permit No. 25162....  
IN NAME OF

**CHARLES H. & FRANCES V. BARRETT**

Surveyed June 3, 1960, by *Ch Jackson*

DFR-10-80