


T. 1 S. R. 4 W. W. M.

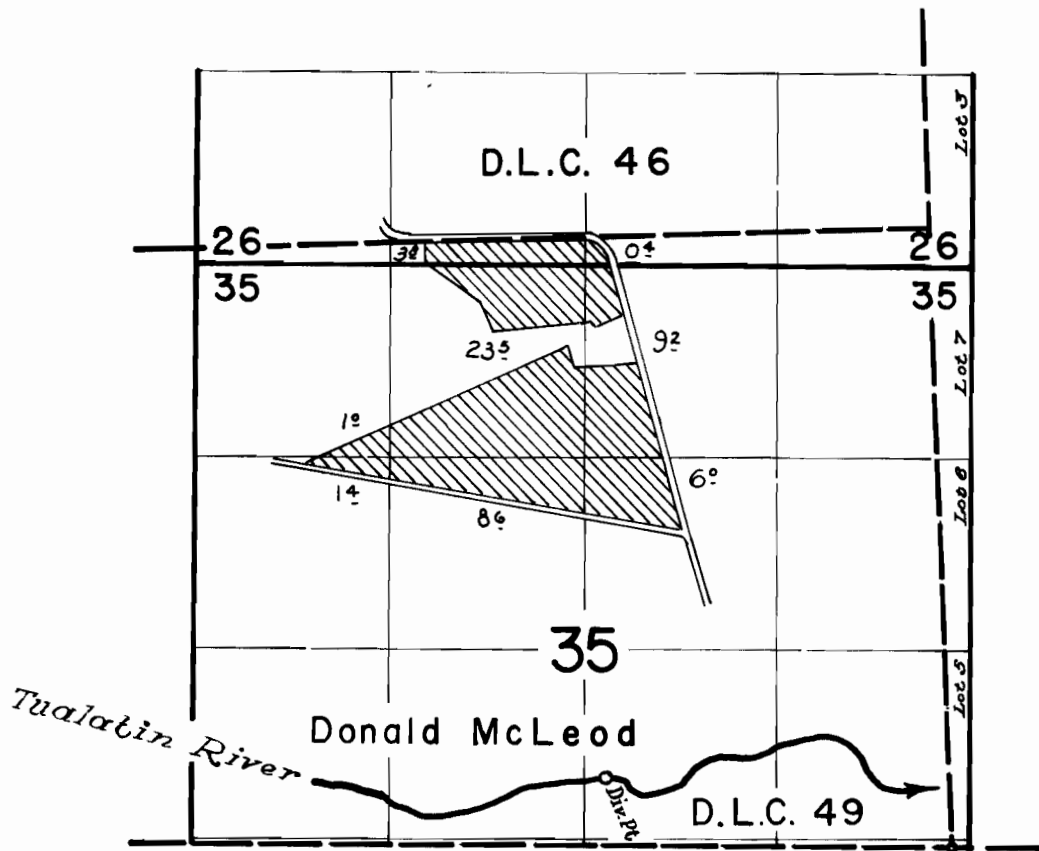

FINAL PROOF SURVEY UNDER

Application No. 32265. Permit No. 25451.
IN NAME OF

HAROLD J. BATES

Surveyed May 25 1960, by *[Signature]*