


T.2 N. R. 5 W.W.M.

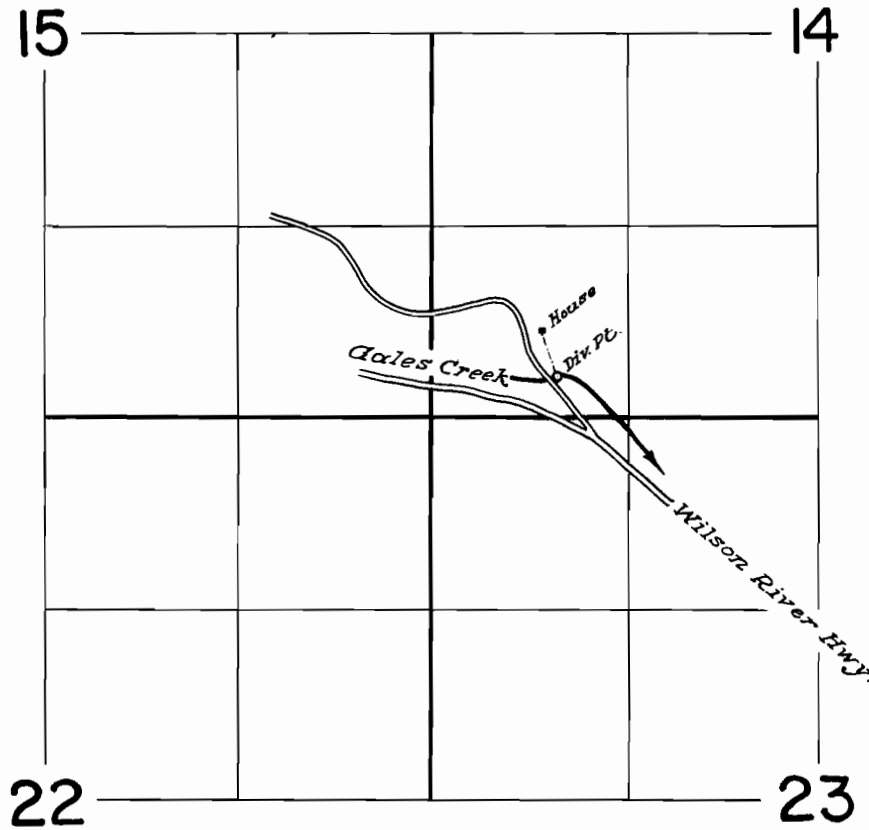

FINAL PROOF SURVEY
UNDER

Application No. 32213... Permit No. 25475...
IN NAME OF

ERNEST SCHOFIELD

Surveyed Sept. 8, 1960, by *[Signature]*