


T.2S.R.2W.W.M.

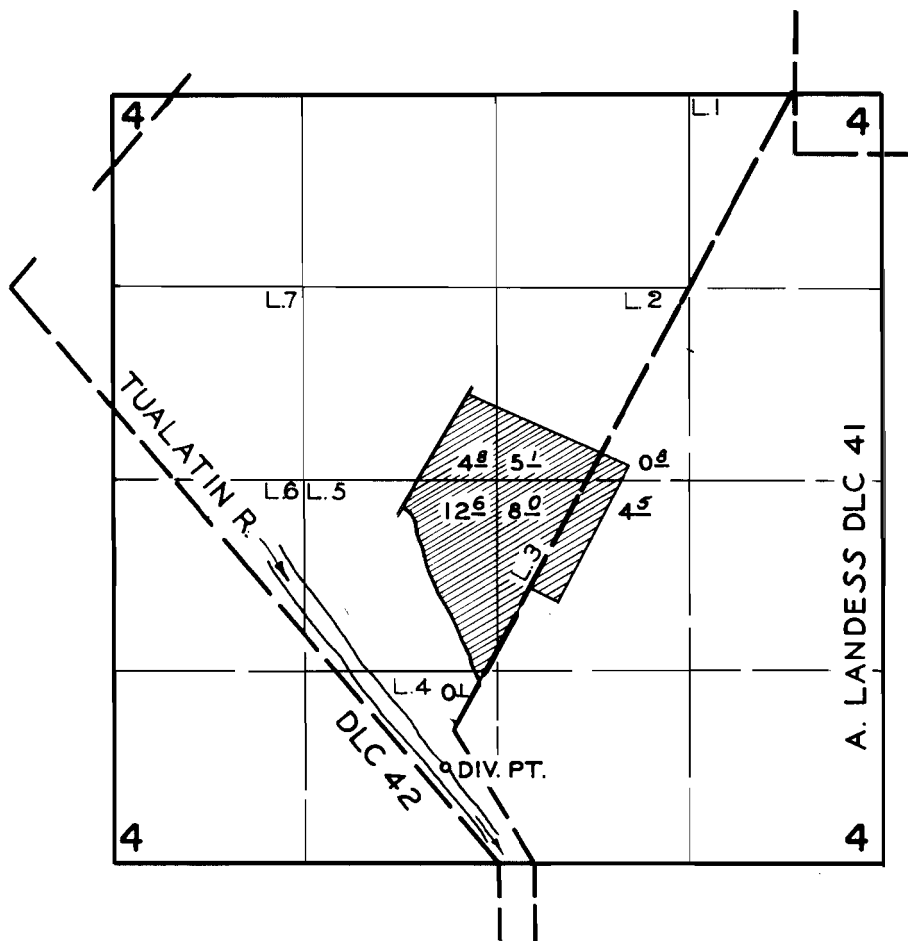

**FINAL PROOF SURVEY**  
UNDER

Application No. 32011..... Permit No. 25255.....  
IN NAME OF

**MARVIN W. & PRISCILLA DECKER**

Surveyed MAY 26, 1960, by R.H. JACKSON.....