


T. 7S. R. 38 & 39 E. W.M.

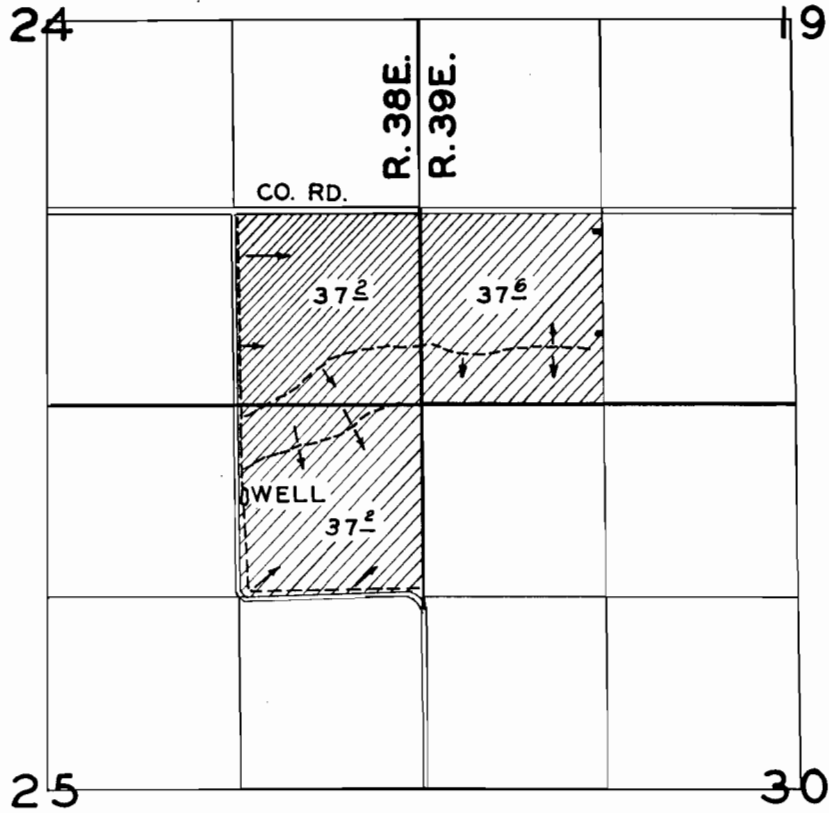

FINAL PROOF SURVEY
UNDER

Application No. G 97 Permit No. G 49
IN NAME OF

LORING W. PERKINS

Surveyed SEPT. 15, 1960, by R.H. JACKSON