


T. 7 S. R. 38 E. W. M.

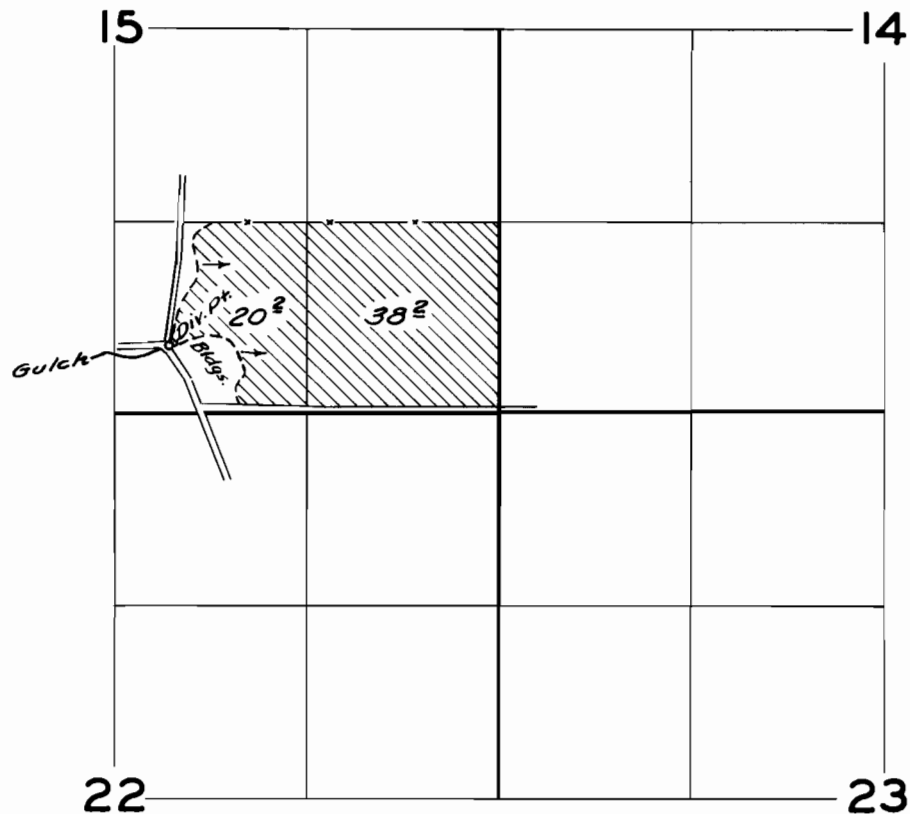

FINAL PROOF SURVEY
UNDER

Application No. 14300 Permit No. 10351
IN NAME OF

Lowell Chandler

Surveyed June 11 1960, by C.O. Bartels