



T.7 S.R.45 E.W.M.

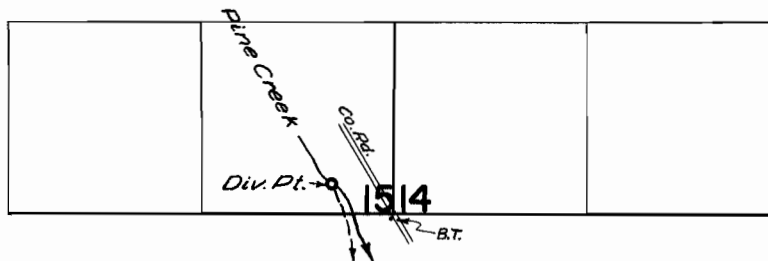

T.8S.R.46E.W.M.

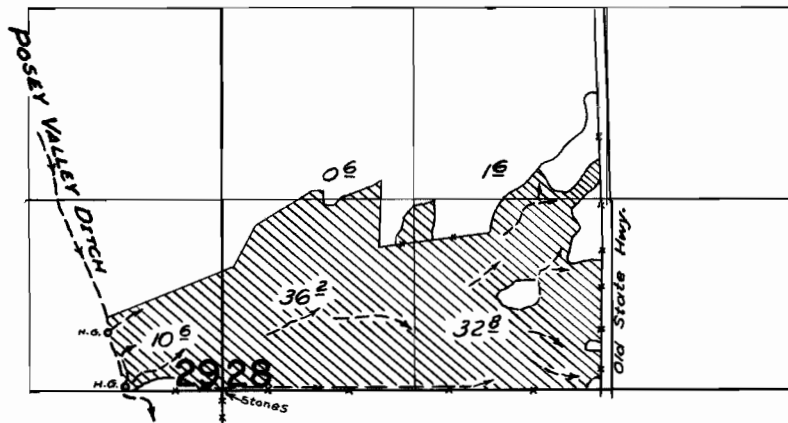

FINAL PROOF SURVEY

UNDER

Application No. 23268 Permit No. 18362
IN NAME OF

Surveyed 13 Sept. 1960, by M. Bish