


T.8S.R.39E.W.M.

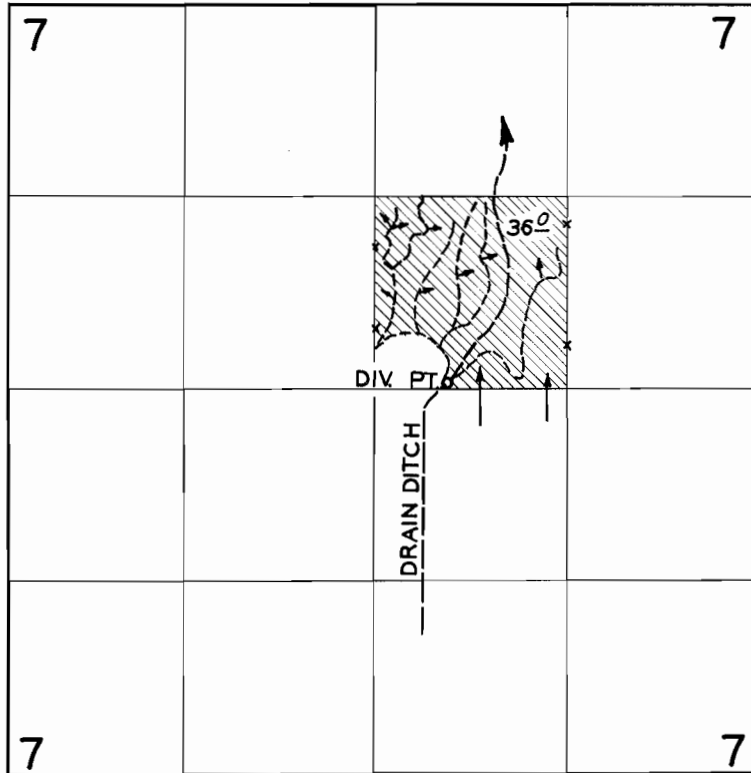

FINAL PROOF SURVEY
UNDER

Application No. 28462 Permit No. 22407
IN NAME OF

HAROLD P. COLVIN

Surveyed SEPT. 15, 1960, by R. H. JACKSON