


T. 8S. R. 42E.W.M.

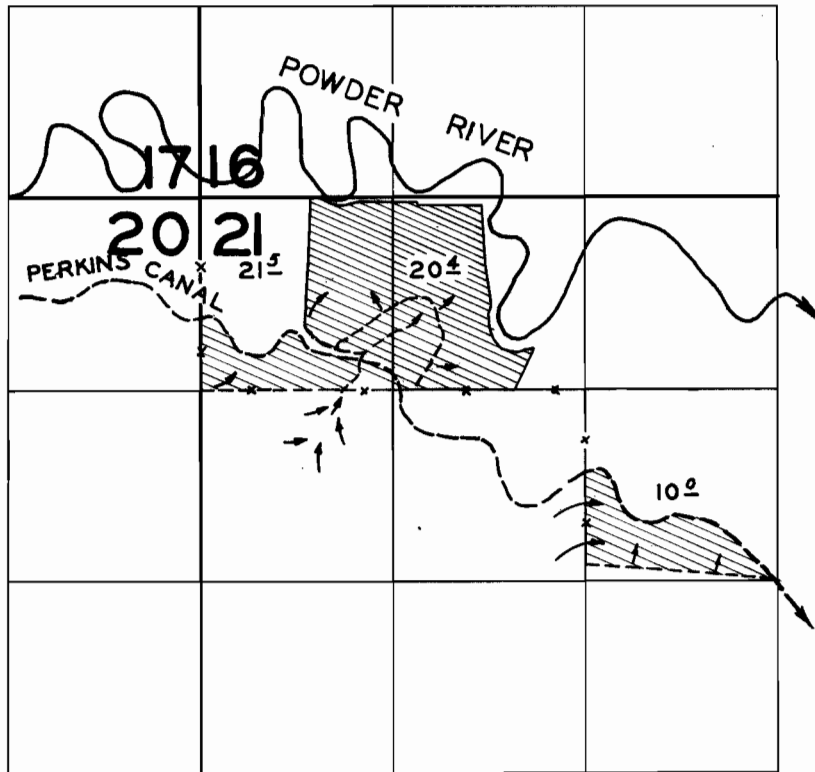

**FINAL PROOF SURVEY**  
UNDER

Application No. 29226 Permit No. 23117  
IN NAME OF

**ROBERT J. & MARGARET STEWARD**

Surveyed SEPT. 14, 1960, by R.H. JACKSON