


T.8S. R.43E.W.M.

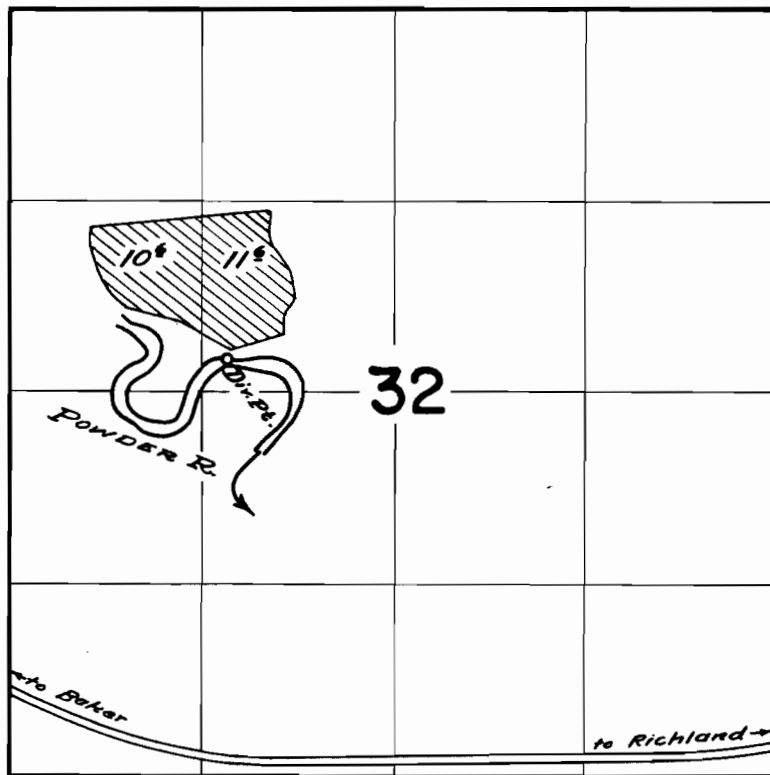

FINAL PROOF SURVEY UNDER

Application No. 31259 Permit No. 24628
IN NAME OF

FLOYD L. PEARSON

Surveyed Sept. 20, 1960, by C.D. Baistick