


T. 9S. R. 39E. W.M.

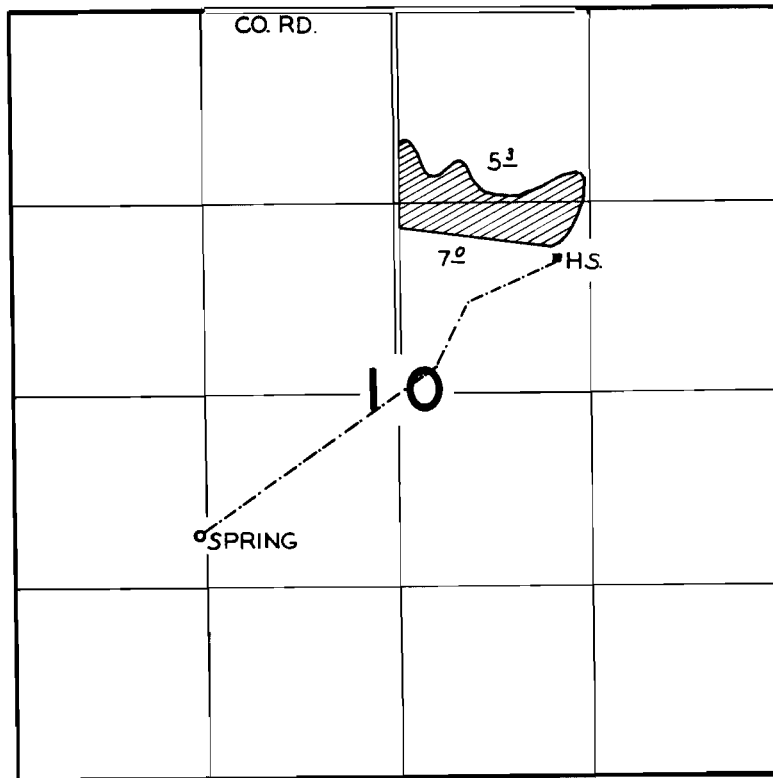

FINAL PROOF SURVEY
UNDER

Application No. 32725 Permit No. 25836
IN NAME OF

HARVEY L. GARDNER

Surveyed SEPT. 17, 1960, by R. H. JACKSON