


T.10S.R. 4W.W.M.

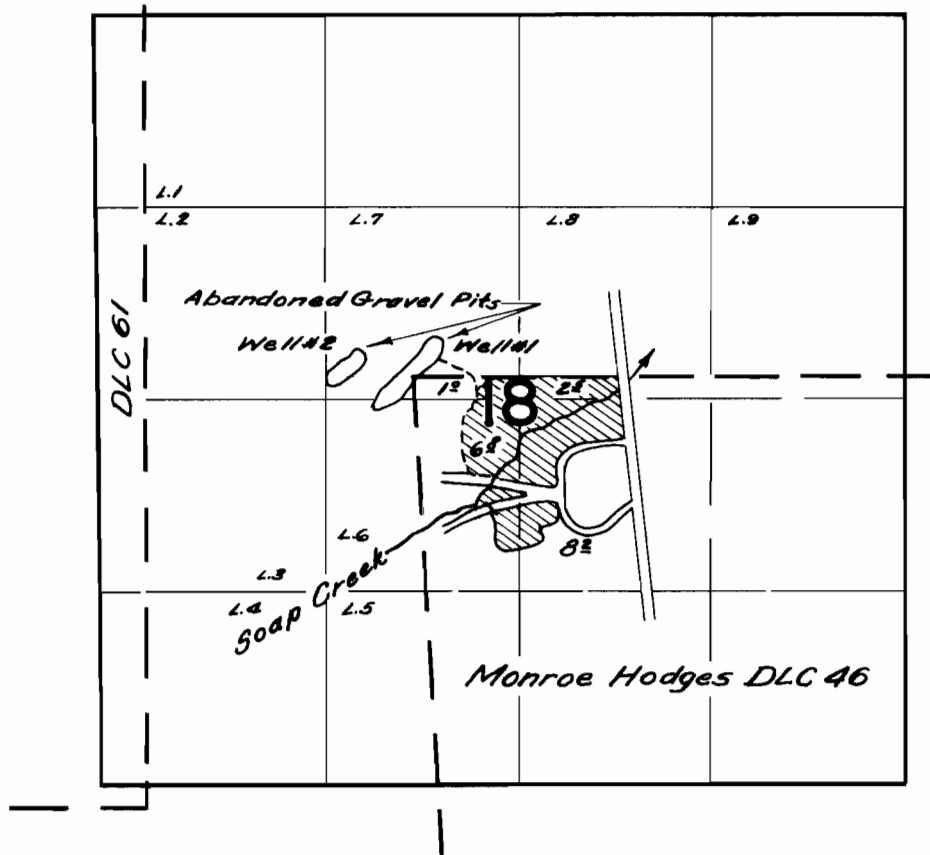

FINAL PROOF SURVEY UNDER

Application No. G-416 Permit No. G-463
IN NAME OF

Leo M. & Agness H. Sullivan

Surveyed Oct. 11, 1960, by C.O. Carter