


T. IIS. R. 4W. W.M.

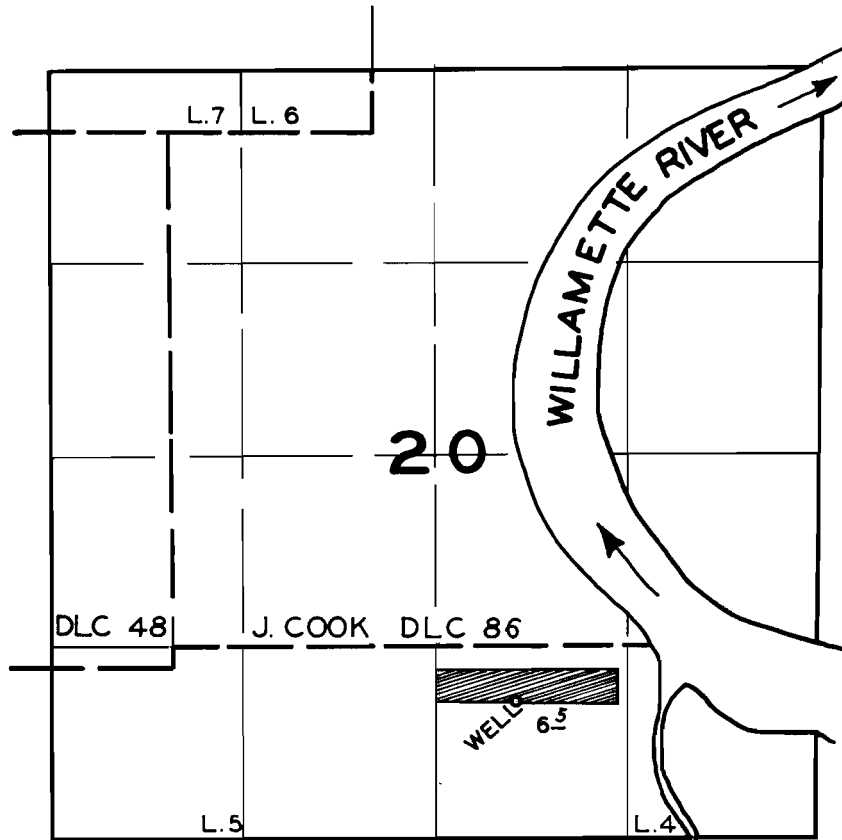

FINAL PROOF SURVEY
UNDER

Application No. G 672 Permit No. G 577
IN NAME OF

WALLACE D. & LOIS B. GREIG

Surveyed JULY 29, 1960, by