


T.1S.R.6W.W.M.

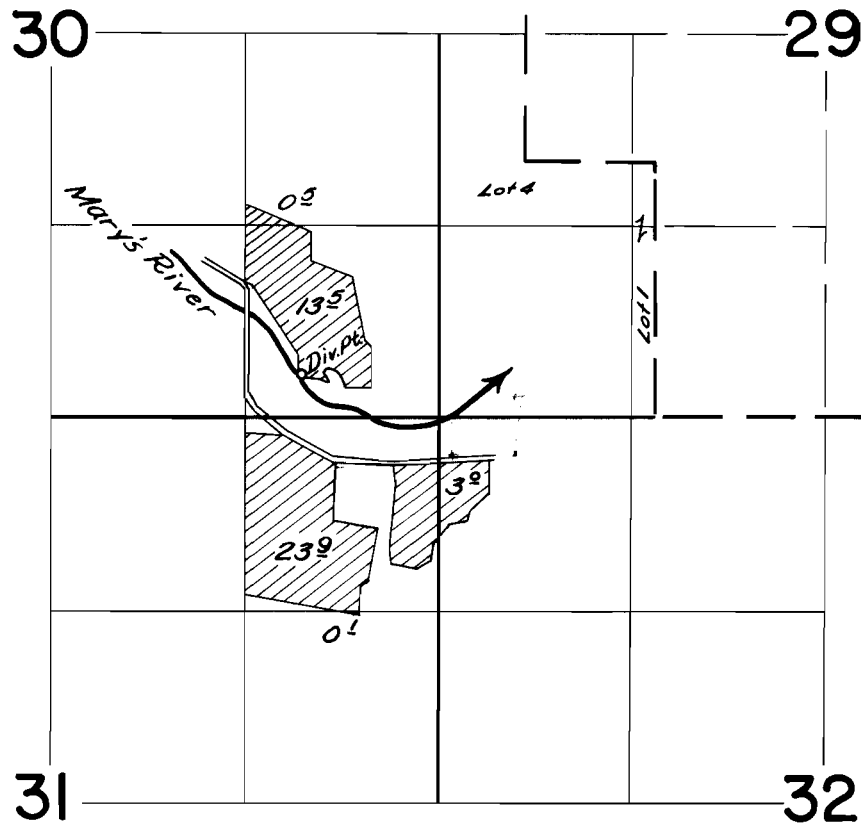

FINAL PROOF SURVEY UNDER

Application No. 26381 Permit No. 29779
IN NAME OF

Gerald & Dorothy Harris

Surveyed Oct. 12, 1960, by C. O. Bartels