


T.12S.R.4W.W.M.

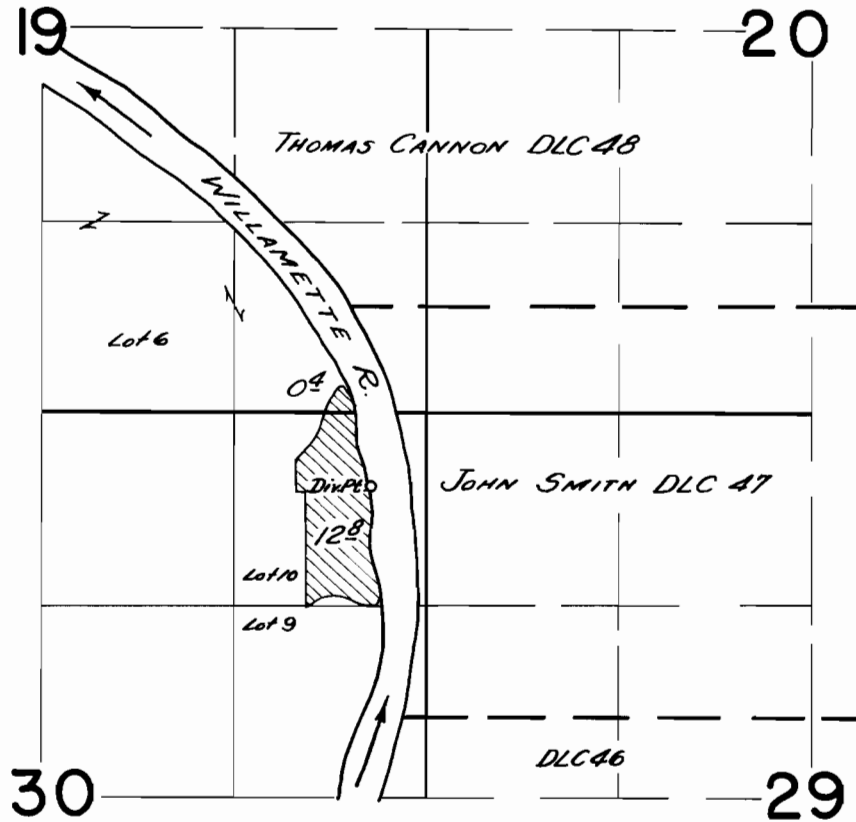

FINAL PROOF SURVEY
UNDER

Application No. *31239* Permit No. *24618*...
IN NAME OF

LOTTIE M. FAGY

Surveyed *Oct. 12, 1960*, by *C.O. Bartels*