


T.14S.R.5W.W.M.

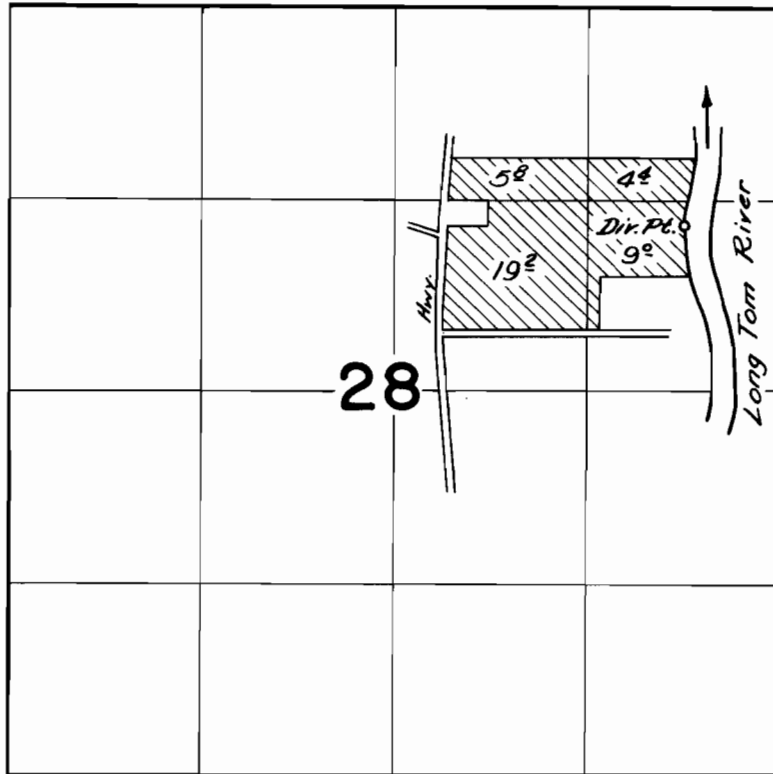

FINAL PROOF SURVEY
UNDER

Application No. *31351* Permit No. *24700*
IN NAME OF

Woodrow K. & Lavinia M. Black

Surveyed *Oct. 13*, 1960, by *C.O. Bastels*