


THE RANWIM

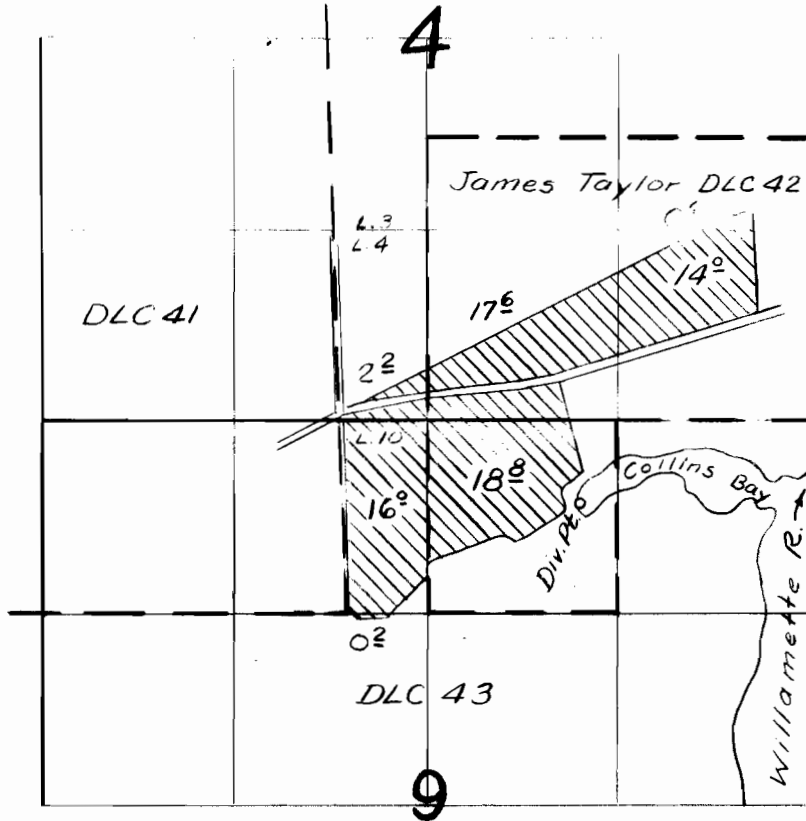

FINAL PROOF SURVEY UNDER

Application No 32489 Permit No. 25650

IN NAME OF

MRS. NORA DULL

Surveyed Oct. 11, 1960 by C.O. Bartels