


T.28S.R.14W.W.M.

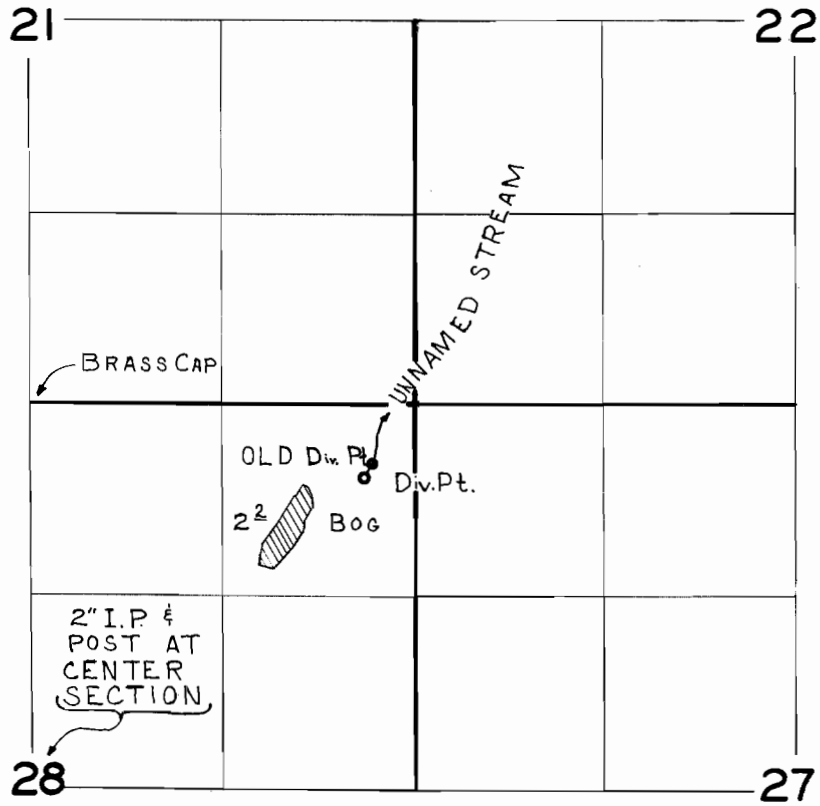

FINAL PROOF SURVEY
UNDER

Application No. 31597... Permit No. 24923...
IN NAME OF

..... R.W. STRONG

Surveyed JUNE 15 1960, by M. BISH