


T.14S. R.15E. W.M.

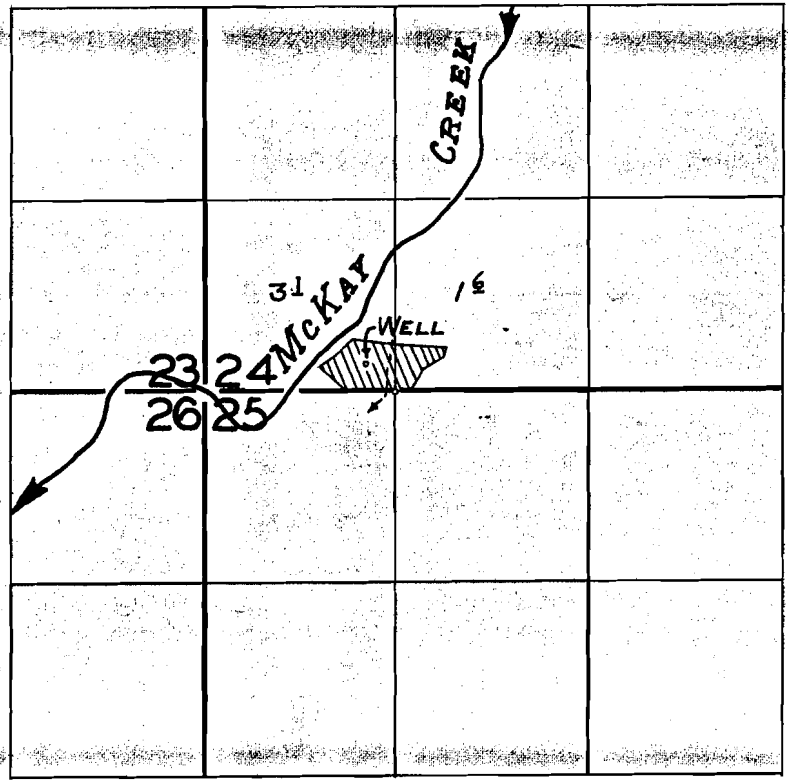

FINAL PROOF SURVEY
UNDER

Application No. G. 1175 Permit No. G. 1055
IN NAME OF

S. V. MORGAN

Surveyed Oct. 7 1960, by M. BISH