


T16S. R.23E.W.M.

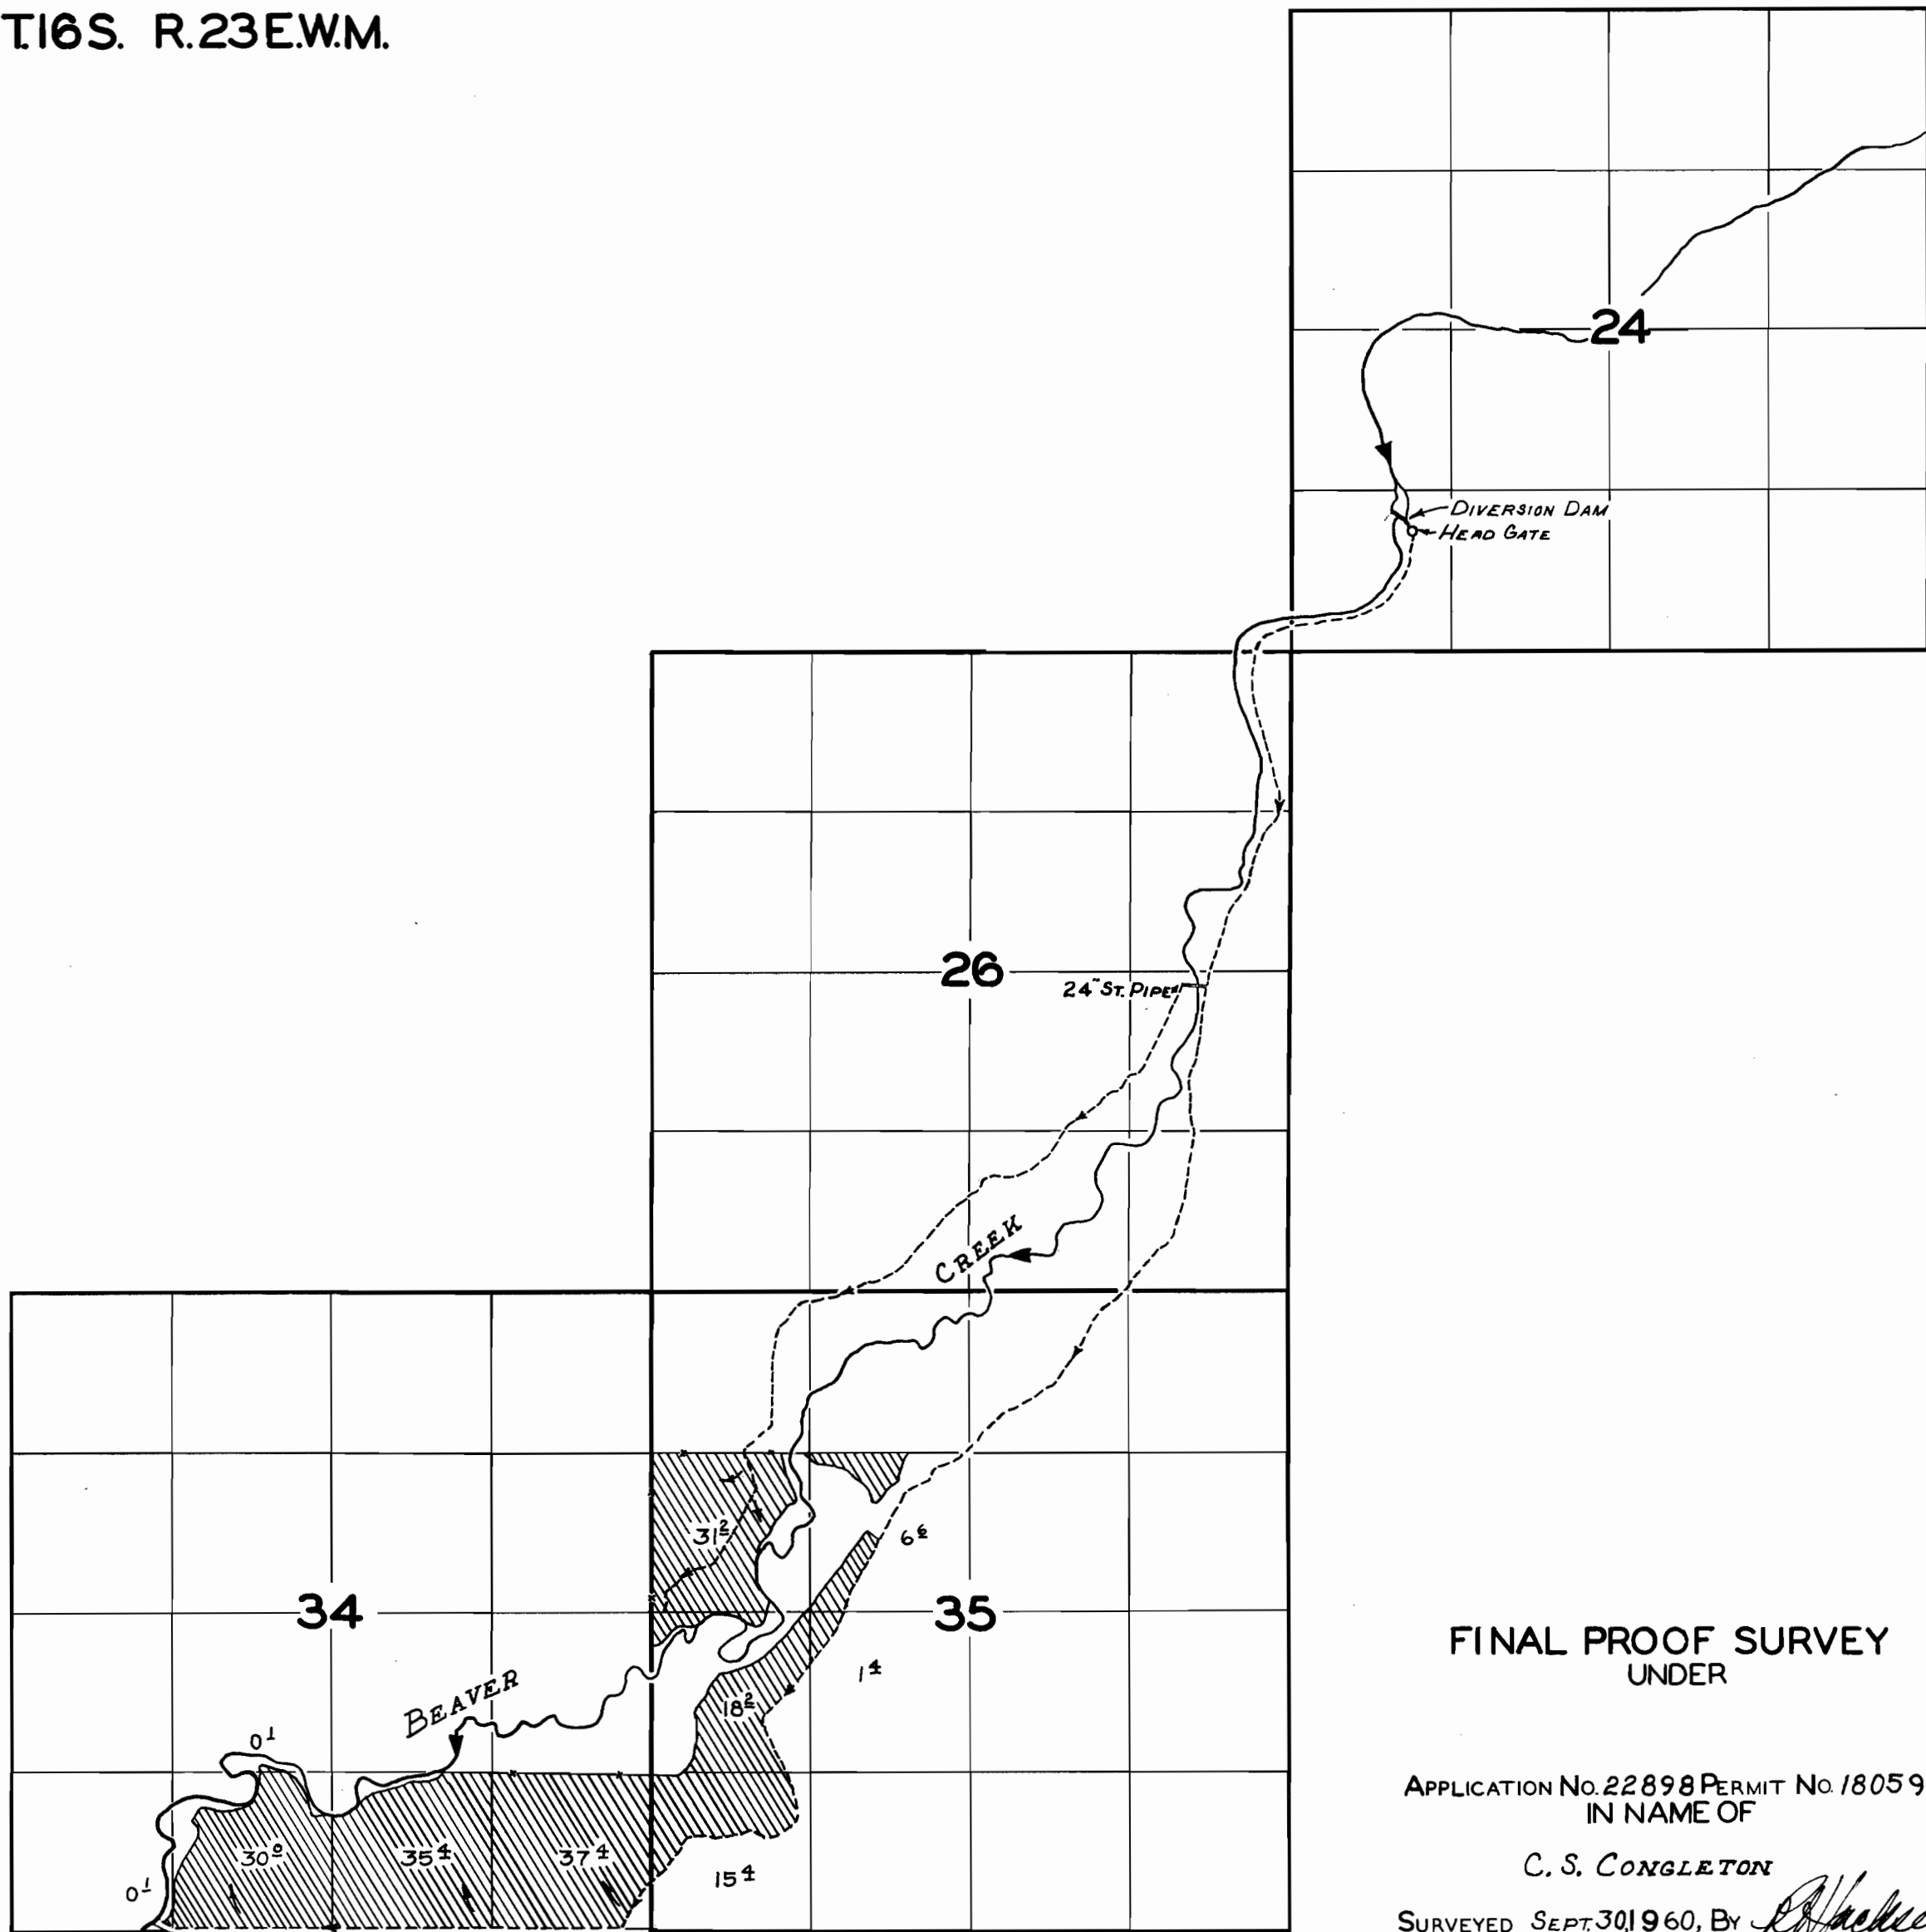

FINAL PROOF SURVEY
UNDER

APPLICATION No. 22898 PERMIT No. 18059
IN NAME OF

C. S. CONGLETON

SURVEYED SEPT. 30, 1960, BY *R. Jackson*

DCY-15H-19