


T.21S. R.23E.W.M.

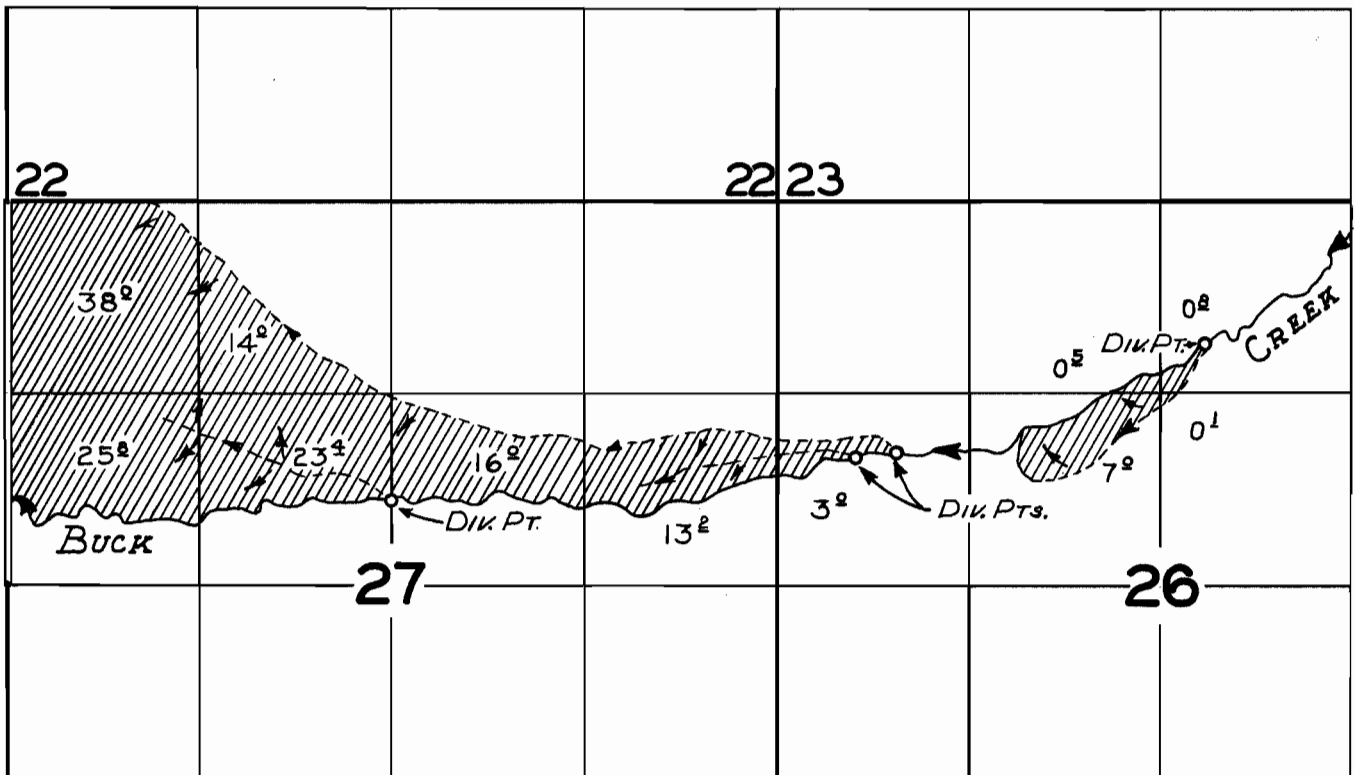

FINAL PROOF SURVEY
UNDER

Application No. 32793 Permit No. 25871
IN NAME OF

GRANT E. BARNEY

Surveyed Oct. 8, 1960, by

[Signature]