


T.26S.R.34E.W.M.

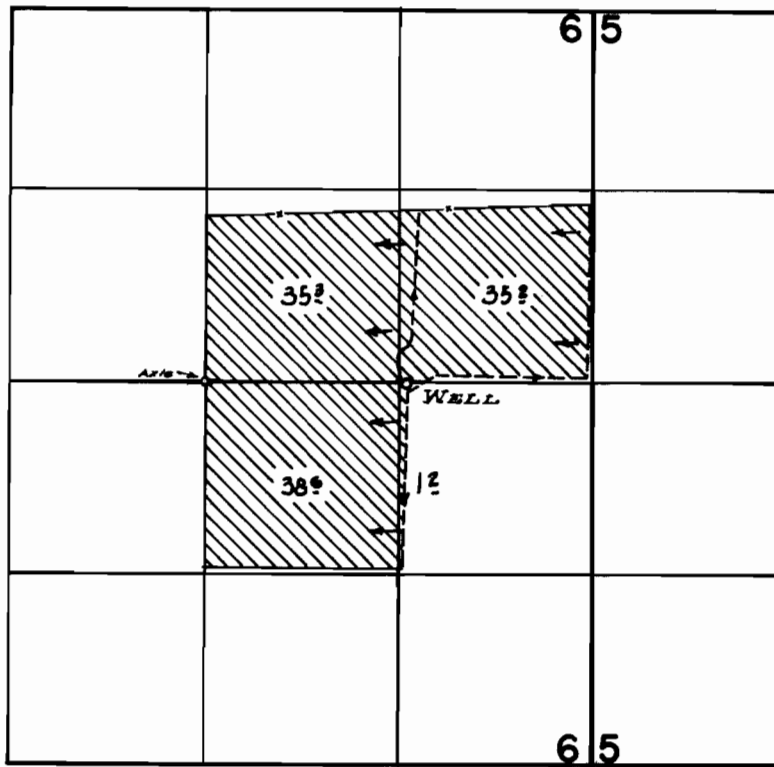

FINAL PROOF SURVEY
UNDER

Application No. G-118 Permit No. G-29
IN NAME OF

HENRY & RAMONA FITCHETT

Surveyed Oct. 21 1960, by [Signature]