


T.23S.R.32E.W.M.

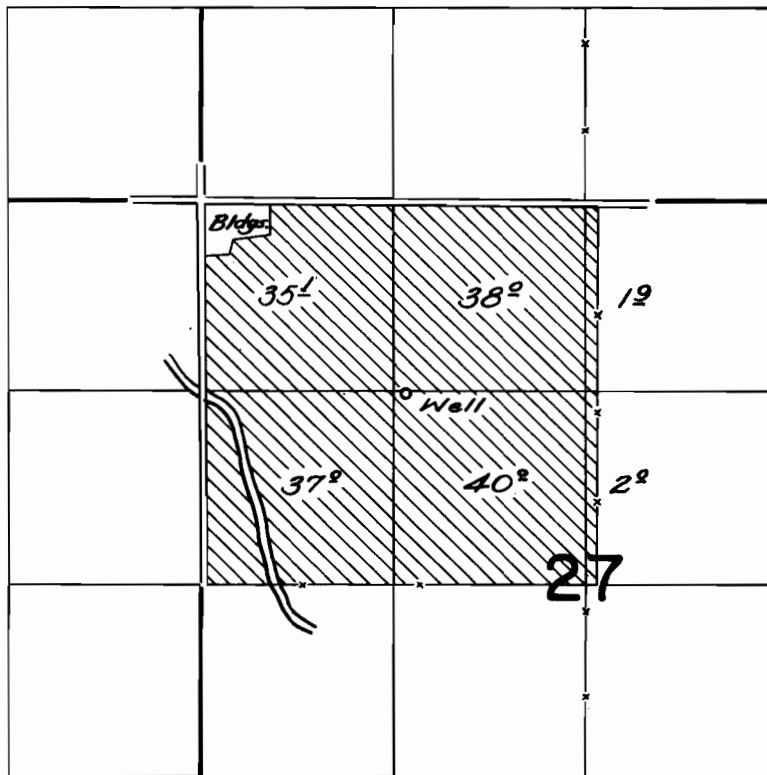

**FINAL PROOF SURVEY**  
UNDER

Application No. *G-92* Permit No. *G-47*  
IN NAME OF

*WAYNE HOWER*

Surveyed *Oct. 22, 1960*, by *C. D. Burt*